

AS-BUILTS

CITY OF GOODYEAR

BULLARD AVENUE AND VAN BUREN STREET WATERLINE

GENERAL NOTES

1. All construction to be performed according to all applicable MAG Standard Details and MAG Specifications, including Supplements to the latest revisions referenced in the contract documents.
2. Facilities which are not specifically located with actual horizontal and vertical controls are located approximately and to the best available information.
3. Existing utilities and other facilities have been placed on the plans from field surveys, existing maps and other current plans within the area of this project. The Contractor will determine the exact location and/or elevation of existing utilities which pertain to and affect the construction of this project.
4. Two working days prior to excavating the Contractor shall call for Blue Stakes. Phone 263-1100, Blue Stake Center.

MAYOR

CARL K. GOW

CITY COUNCIL

FRED AMATOR
 WILLIAM ARNOLD
 MIKE KETCHAM
 JOHN LEACH
 JOHN N. MAXWELL
 STEPHANIE RICHMOND

CITY MANAGER

STEPHEN S. CLEVELAND

APPROVAL:

Stephen S. Cleveland

9-13-90
DATE


APPROVAL:

Donald Cowy PE 90238


9/17/90

MARICOPA COUNTY HEALTH DEPT.

THIS PROJECT

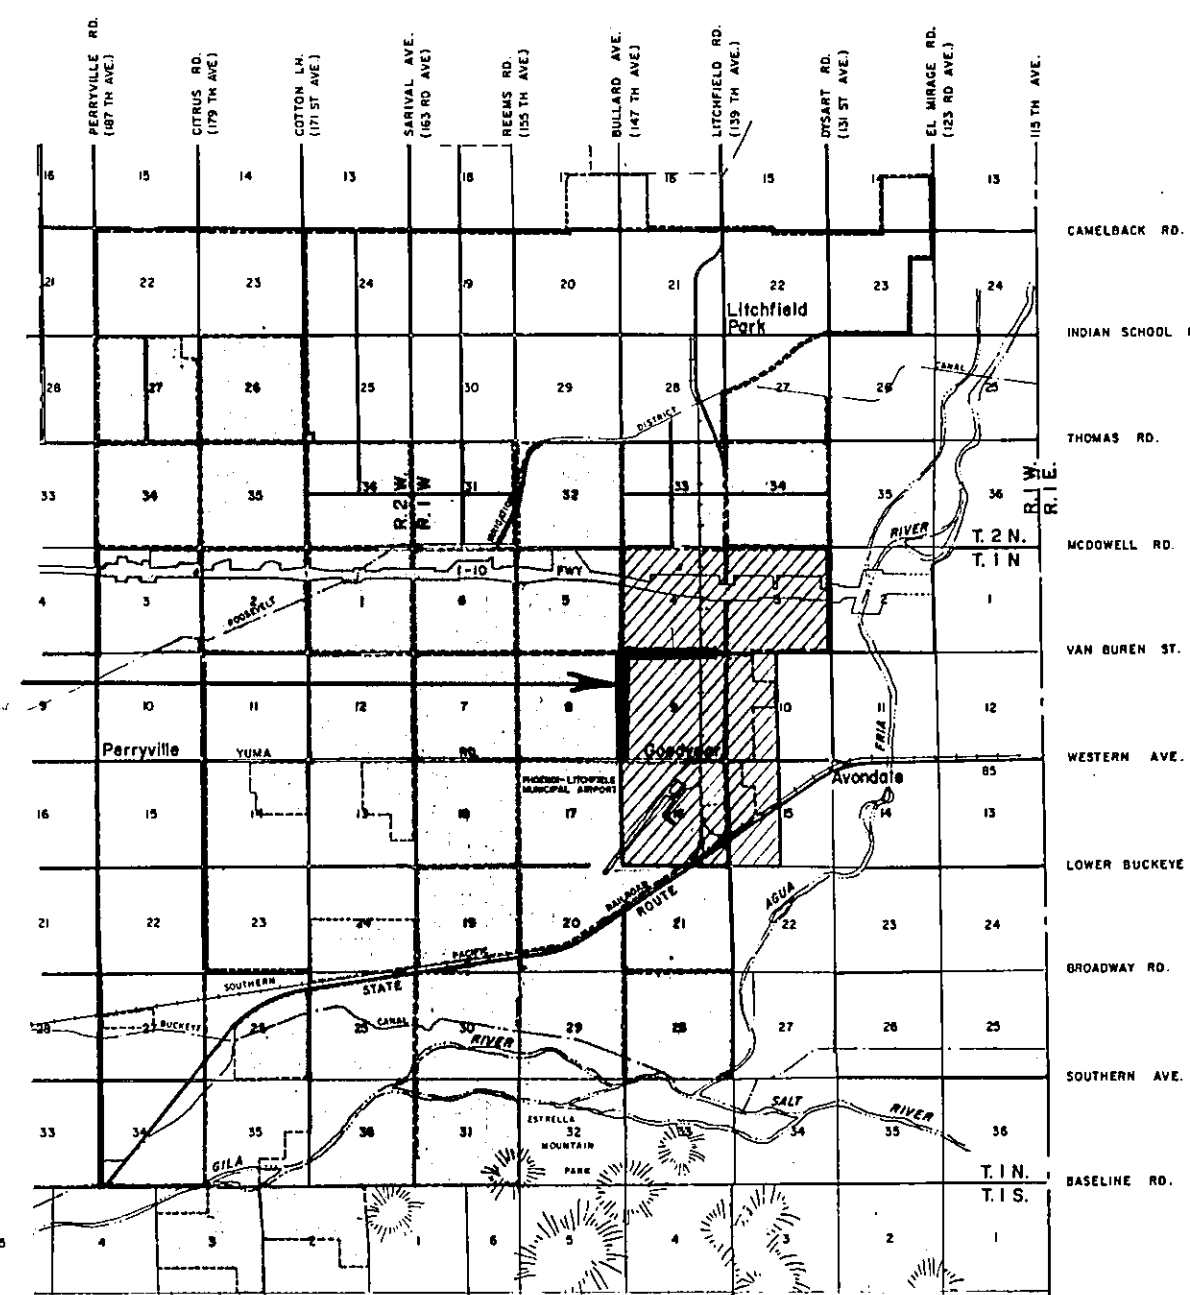

VICINITY MAP

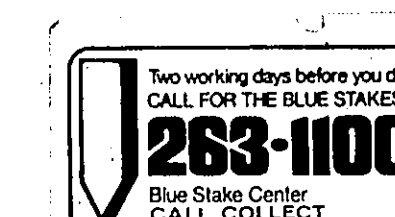

F. Robert Stearns
8-20-90

AS-BUILT 2/28/91



YOST AND GARDNER ENGINEERS
 2619 NORTH THIRD STREET
 PHOENIX, ARIZONA 85004

FEBRUARY 1990,


JOB NO. 6355

SHEET 1 OF 10

1991-002-C1

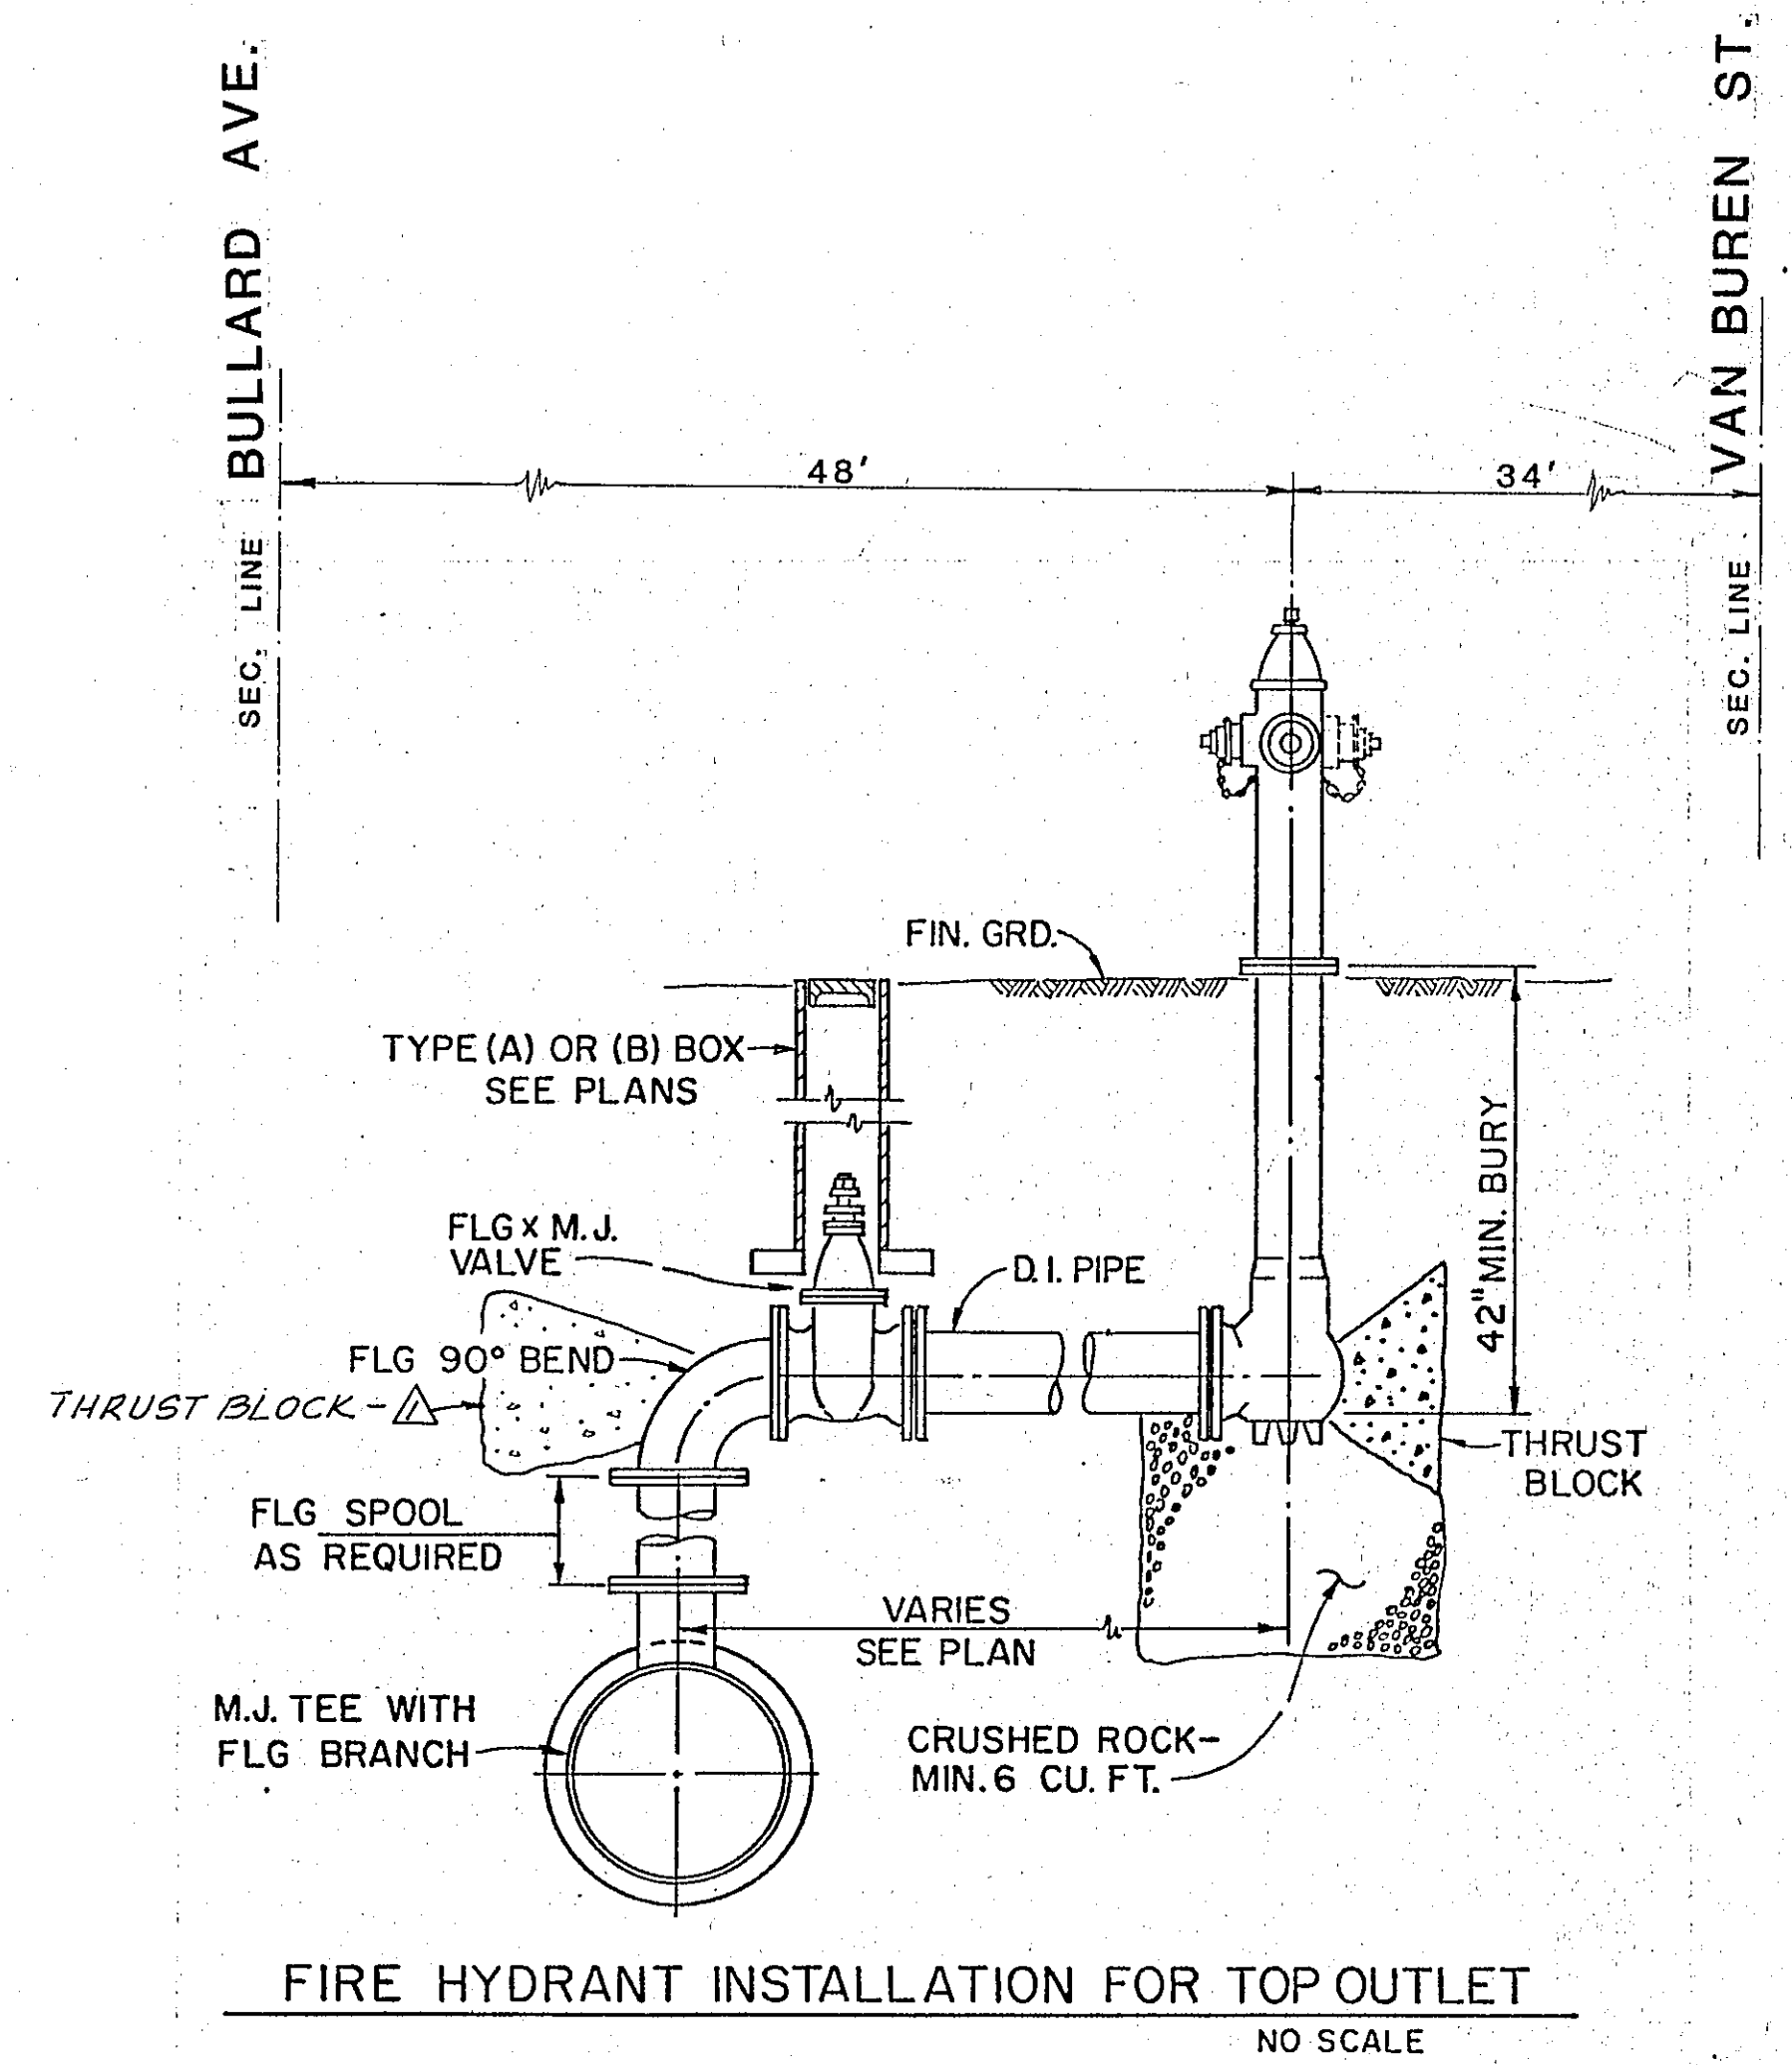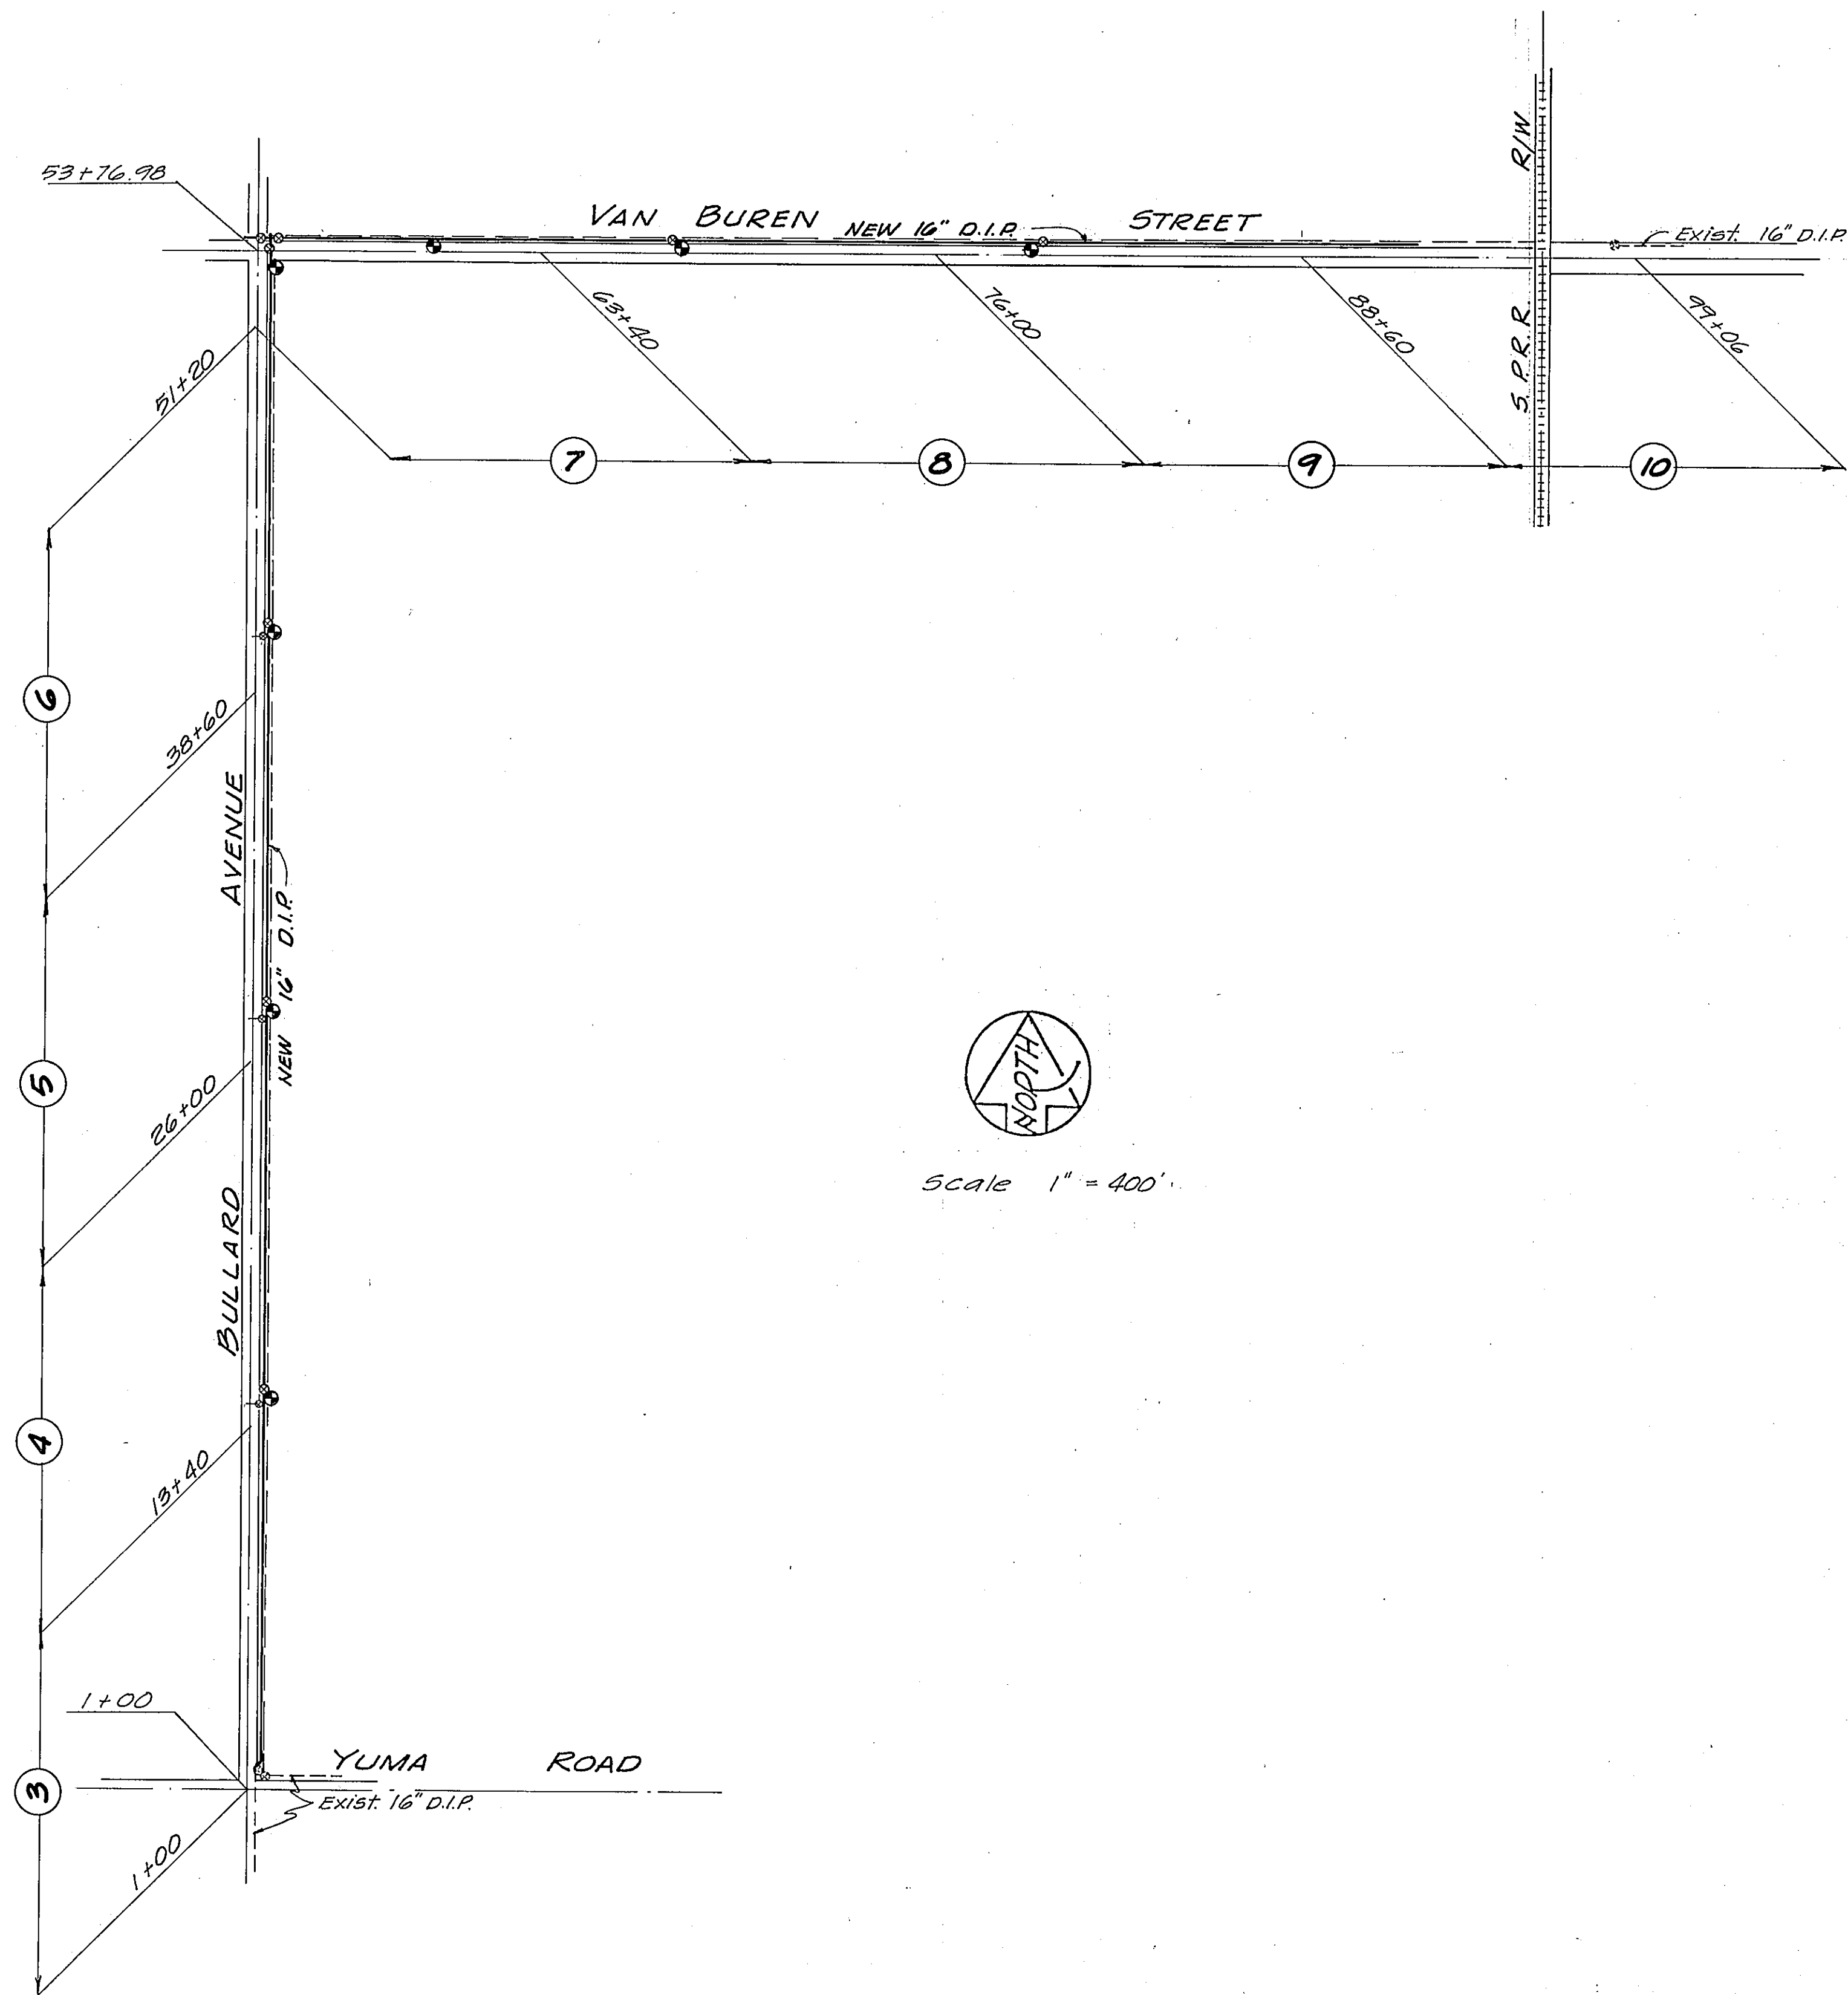

AS-BUILT - 2/28/91 F.R.S.

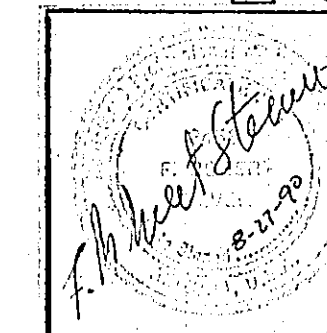



CITY OF GOODYEAR, ARIZONA

BULLARD AVE. - VAN BUREN ST. WATERLINE
KEY MAP

YOST AND GARDNER ENGINEERS
2619 N. 3RD STREET - PHOENIX, ARIZ.
Dr. L.R. PCK, G.C. Date: 6/90 Job No. 6355 Sht. 2 / 10

PLAN	CHECKED	DATE
	BY	
	NO. OF WAYS CHECKED	
	ALIGNED CHECKED	
	PLOTTED	
	NOTE BOOK NO.	

PROFILE	CHECKED	DATE
	BY	
	NO. OF WAYS CHECKED	
	GRADES CHECKED	
	PLOTTED	
	NOTE BOOK NO.	
	STRUCTURE NOTATIONS CHECKED	



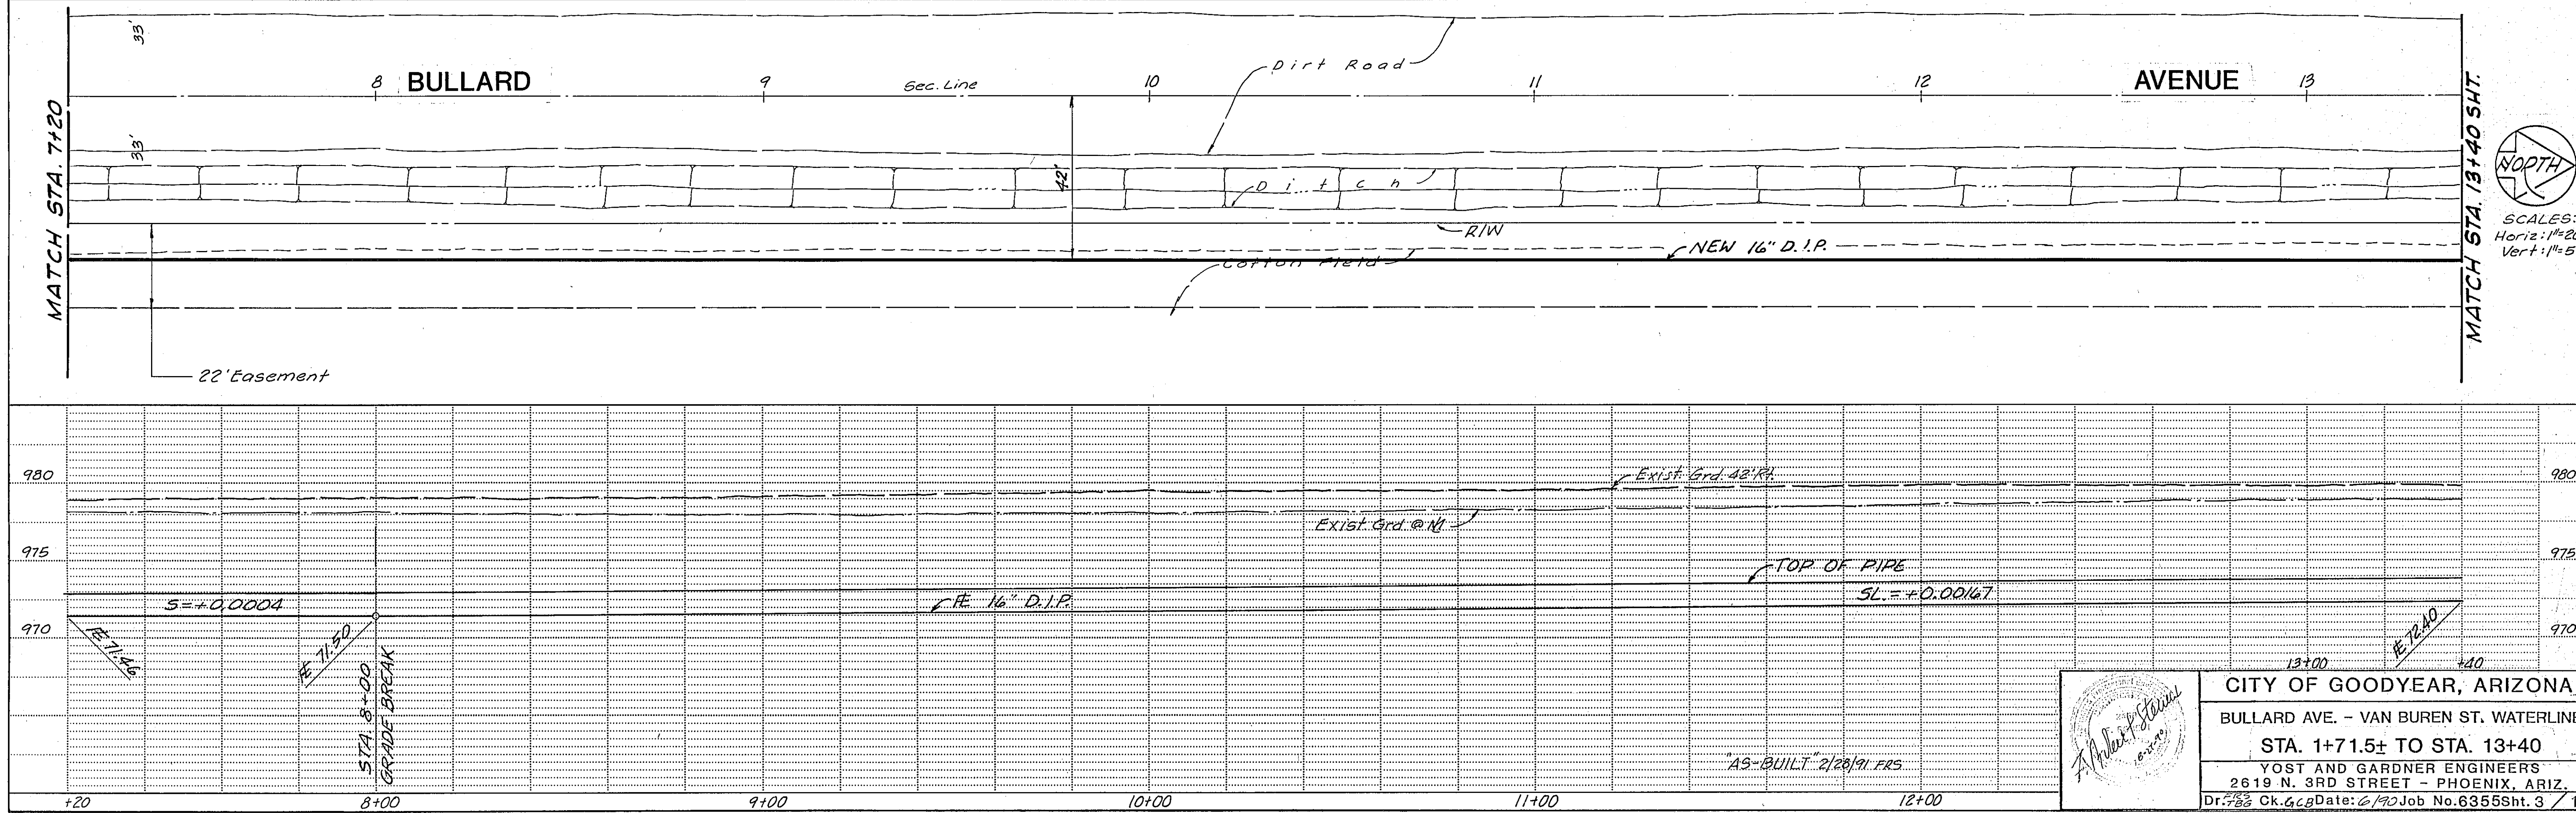
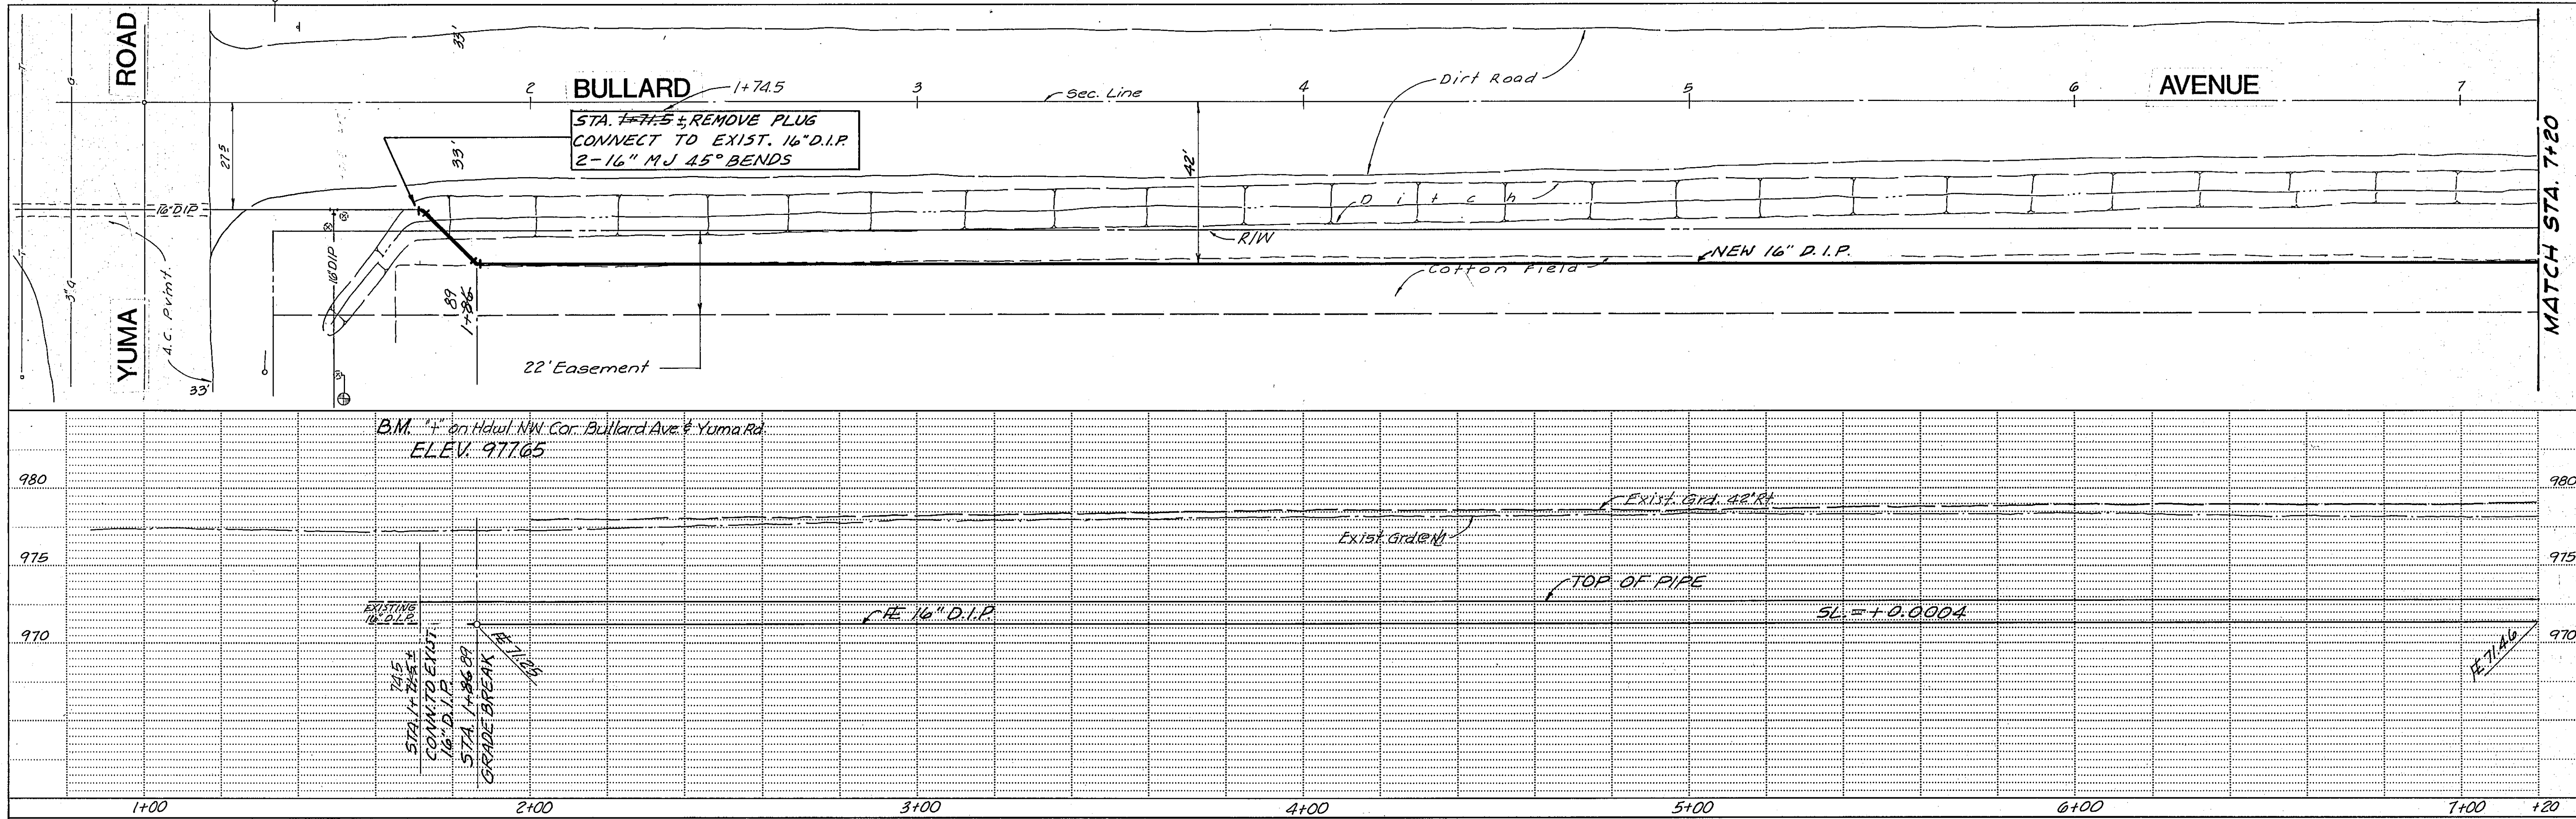


A. H. ...
 6/19/90

CITY OF GOODYEAR, ARIZONA
 BULLARD AVE. - VAN BUREN ST. WATERLINE
 STA. 1+71.5± TO STA. 13+40
 YOST AND GARDNER ENGINEERS
 2619 N. 3RD STREET - PHOENIX, ARIZ.
 Dr. 5/83 Ck. GCB Date: 6/19/90 Job No. 6355 Sht. 3 / 10

BY	DATE
SURVEYED	
PLANNED	
NOTED	
NO.	



BY	DATE
SURVEYED	
PLANNED	
NOTED	
NO.	

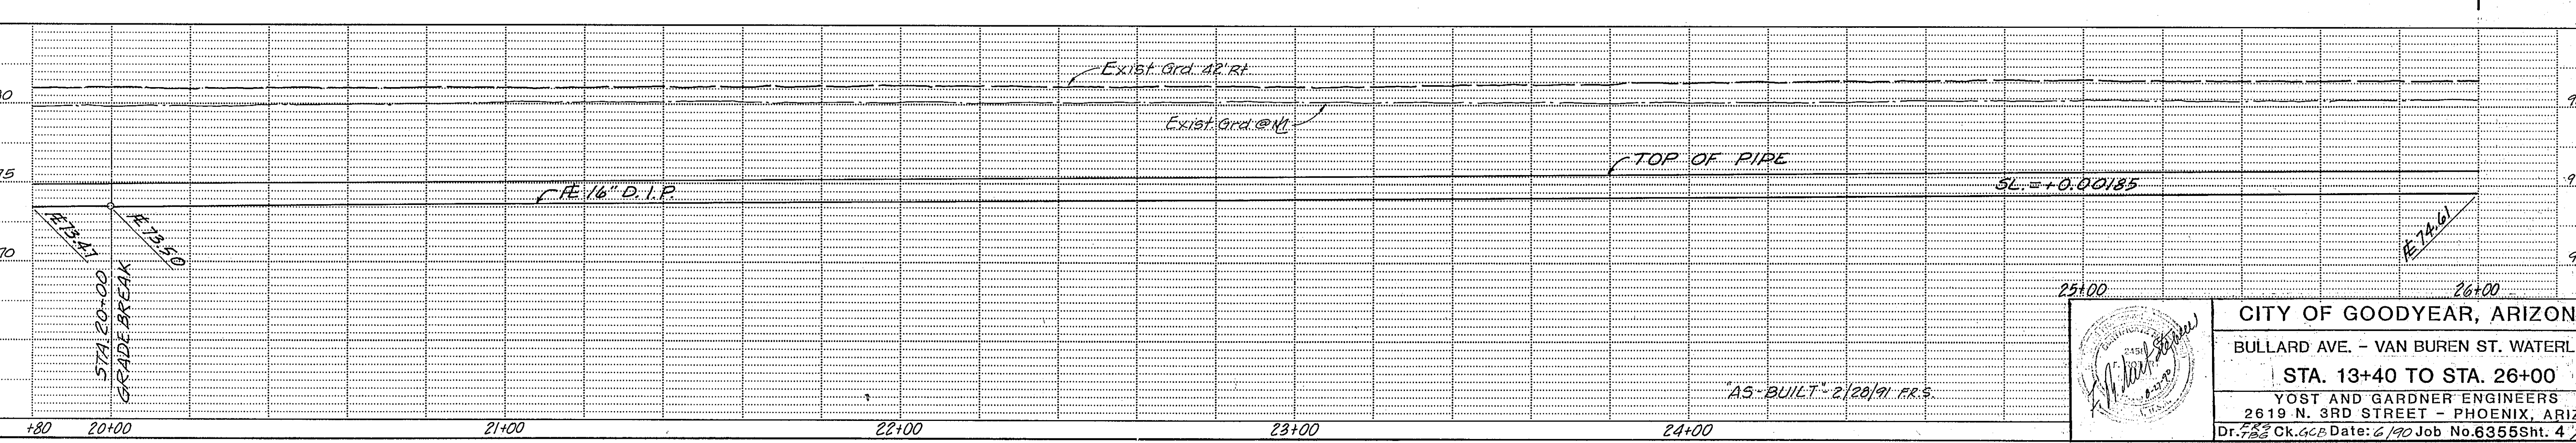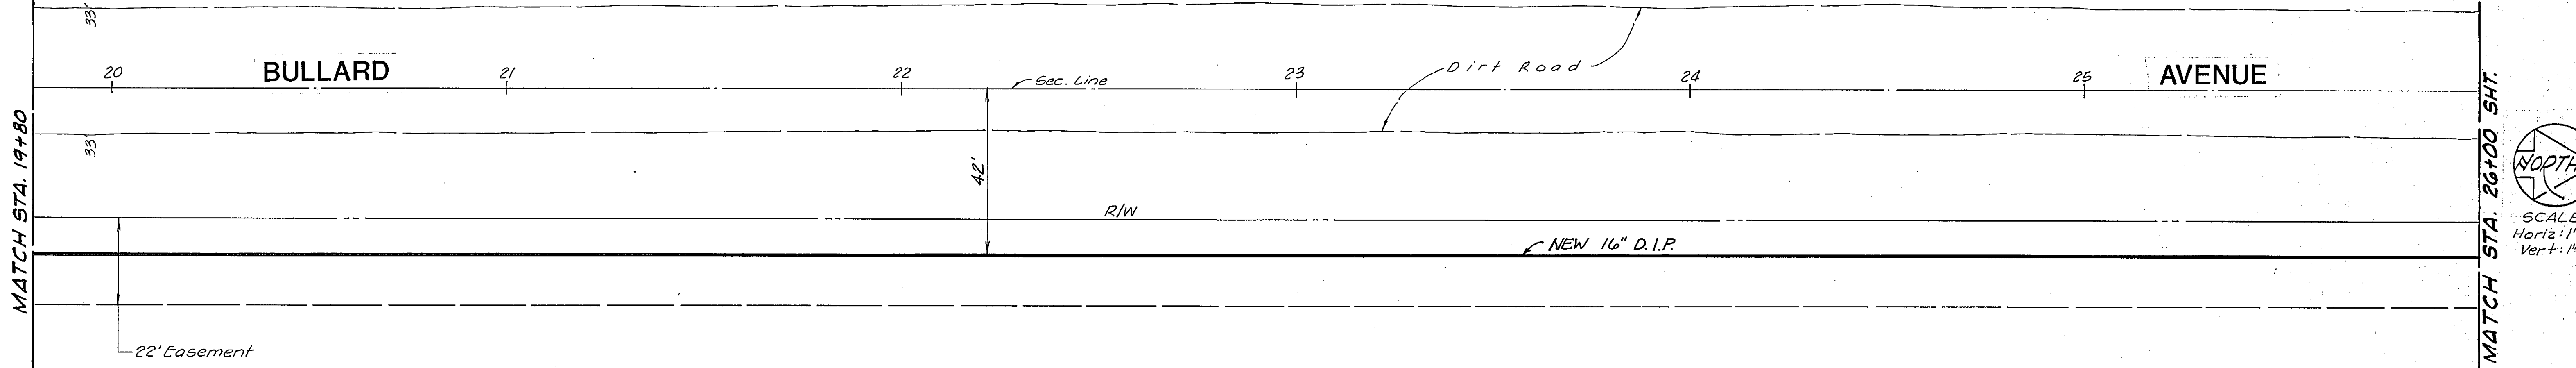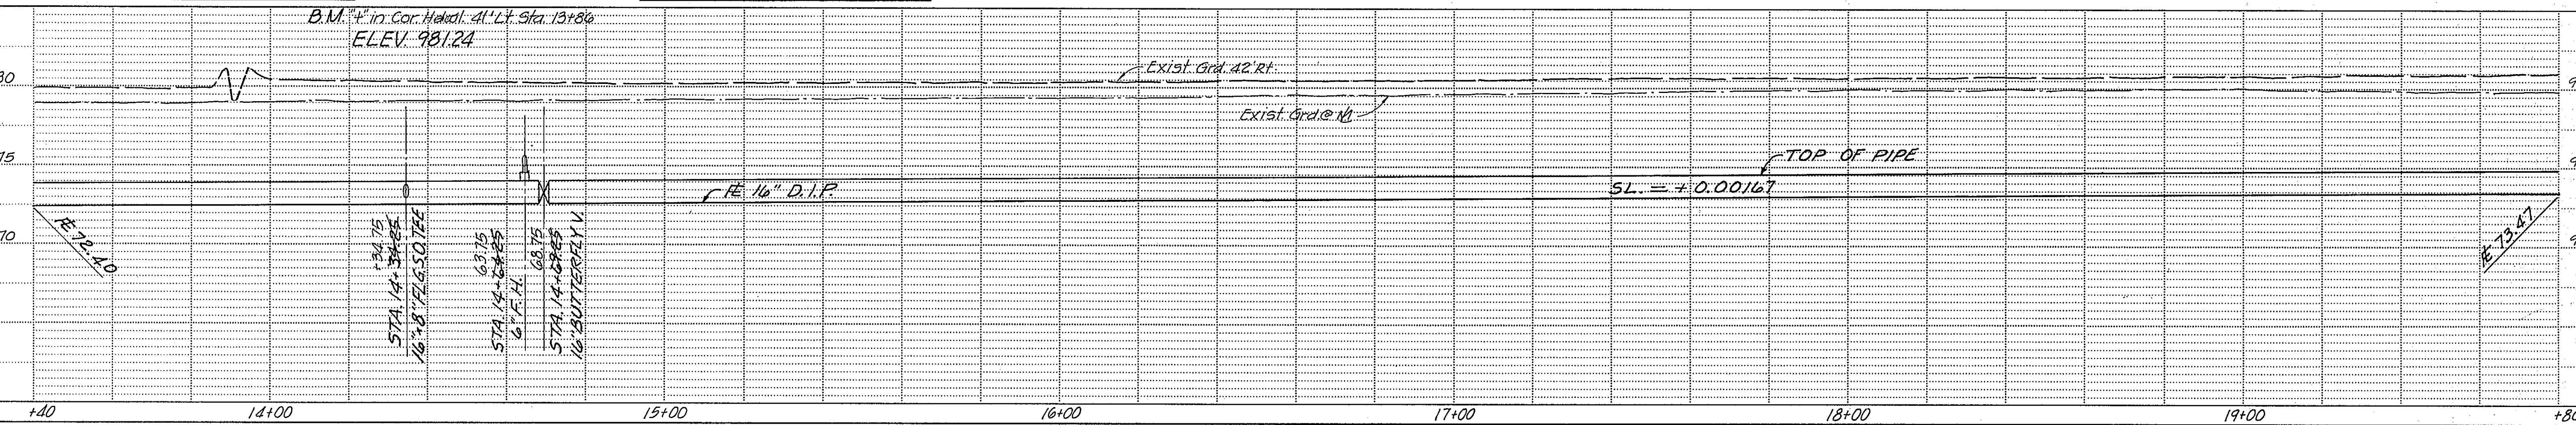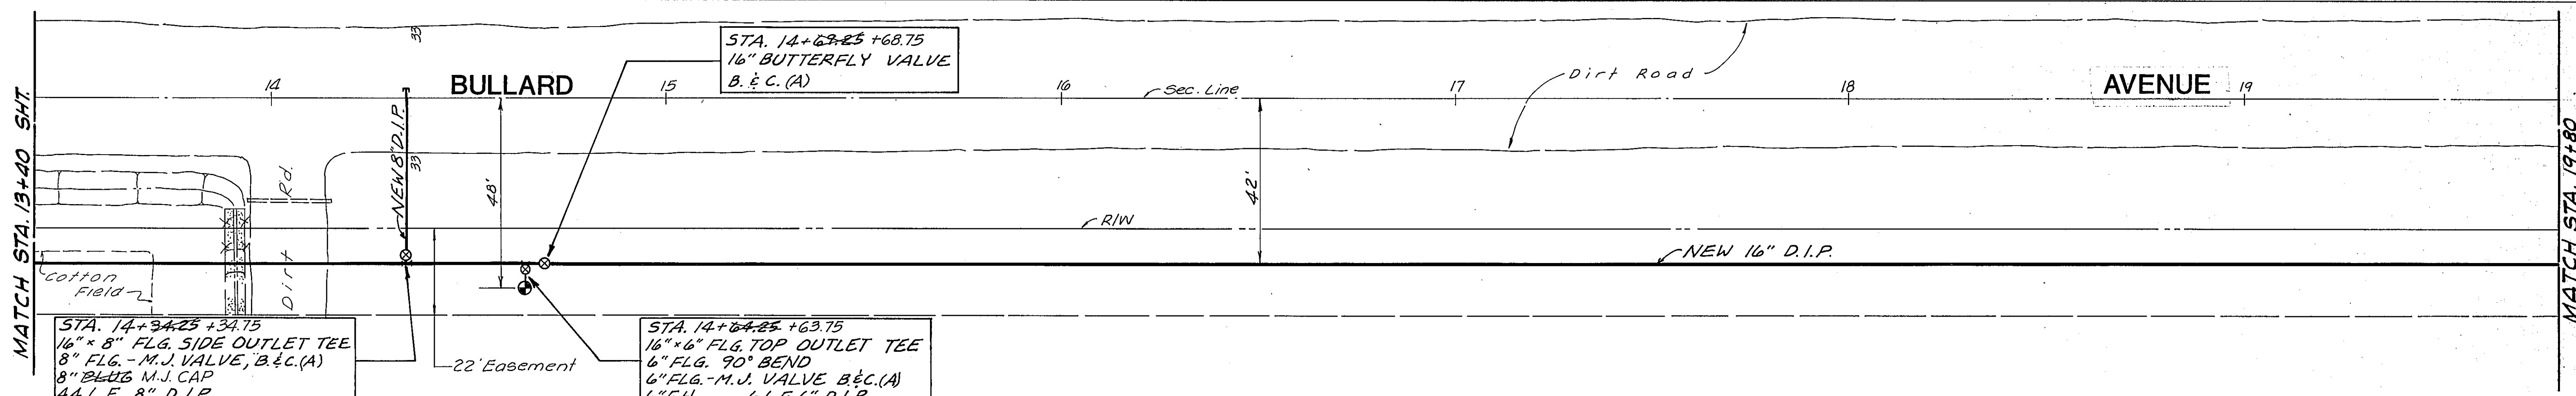


CITY OF GOODYEAR, ARIZONA
 BULLARD AVE. - VAN BUREN ST. WATERLINE
 STA. 13+40 TO STA. 26+00
 YOST AND GARDNER ENGINEERS
 2619 N. 3RD STREET - PHOENIX, ARIZ.
 Dr. FRG CK. GCB Date: 6/10 Job No. 6355 Sht. 4 / 10


PLAN	SURVEYED	DATE
	PLOTTED	BY
	CHECKED	
	BY	
	NO. OF WAY CHECKED	
	NO.	

PROFILE	SURVEYED	DATE
	PLOTTED	BY
	CHECKED	
	BY	
	NO. OF WAY CHECKED	
	NO.	

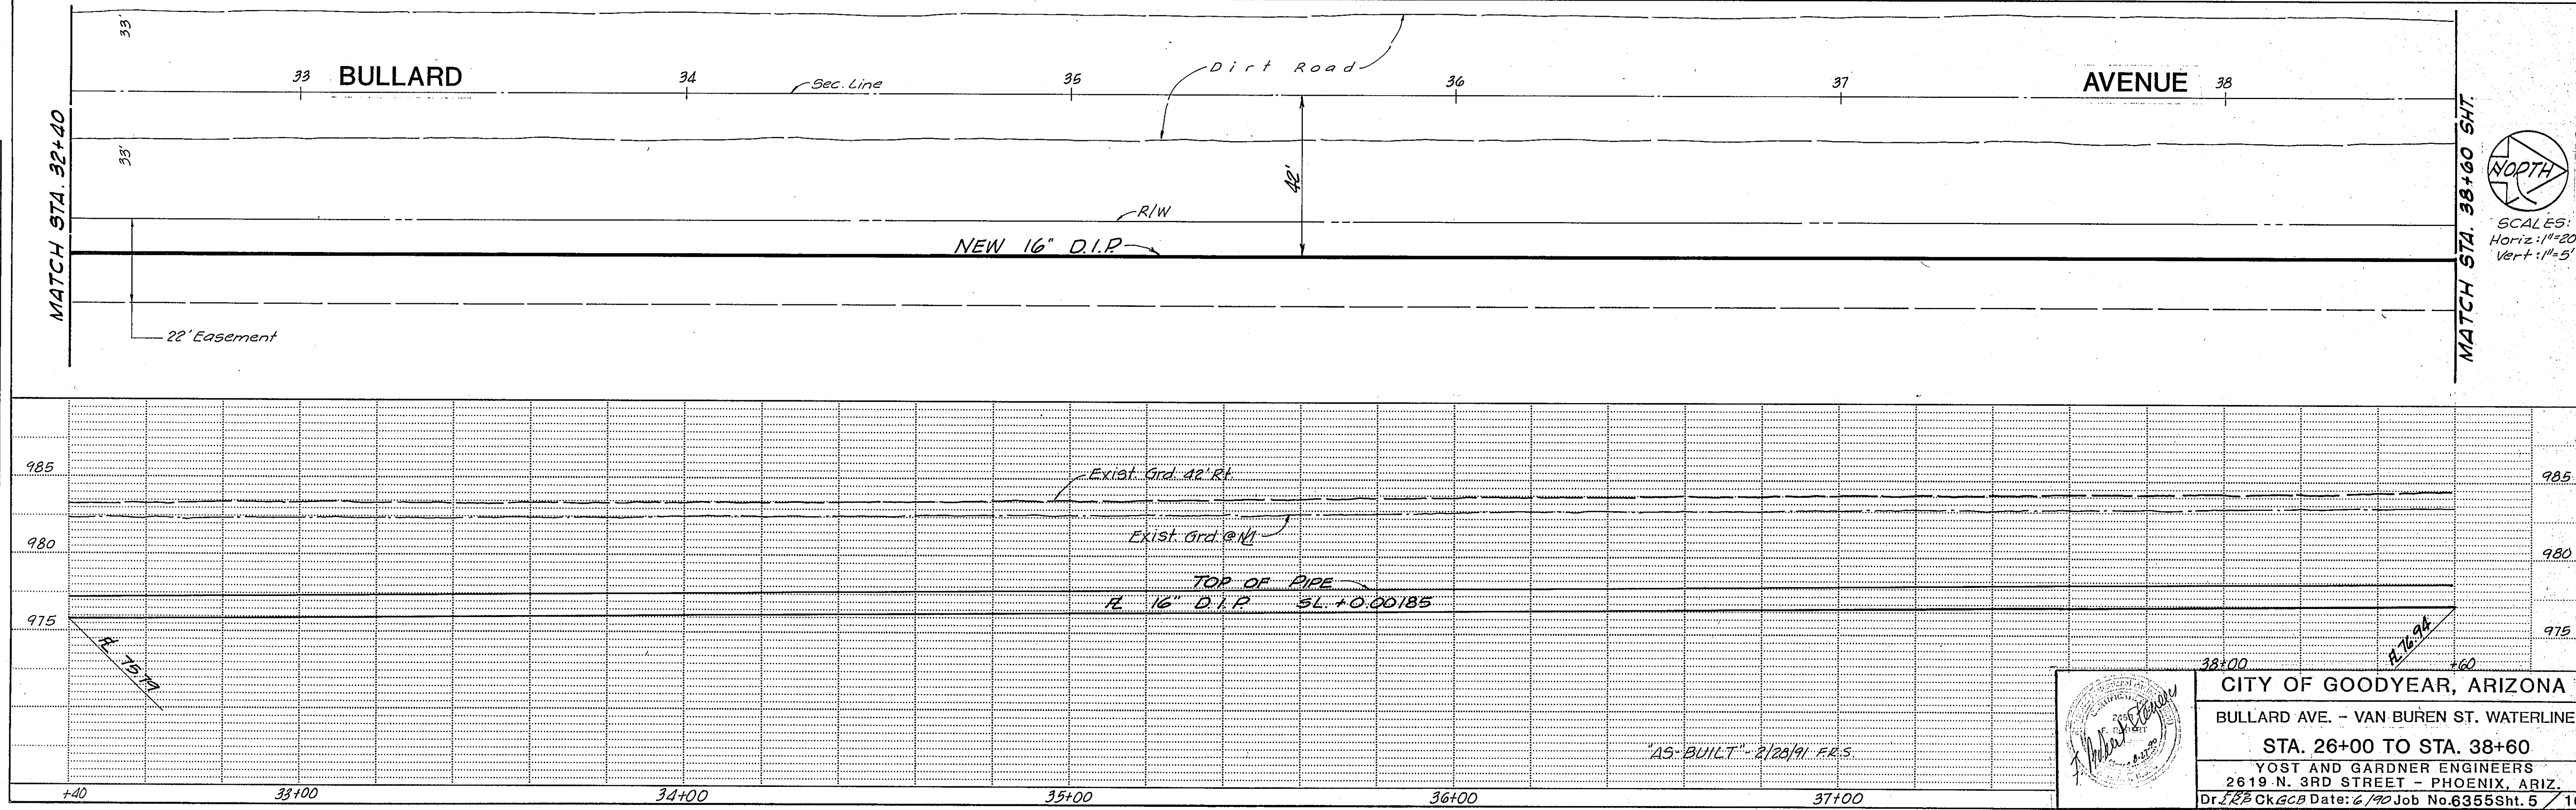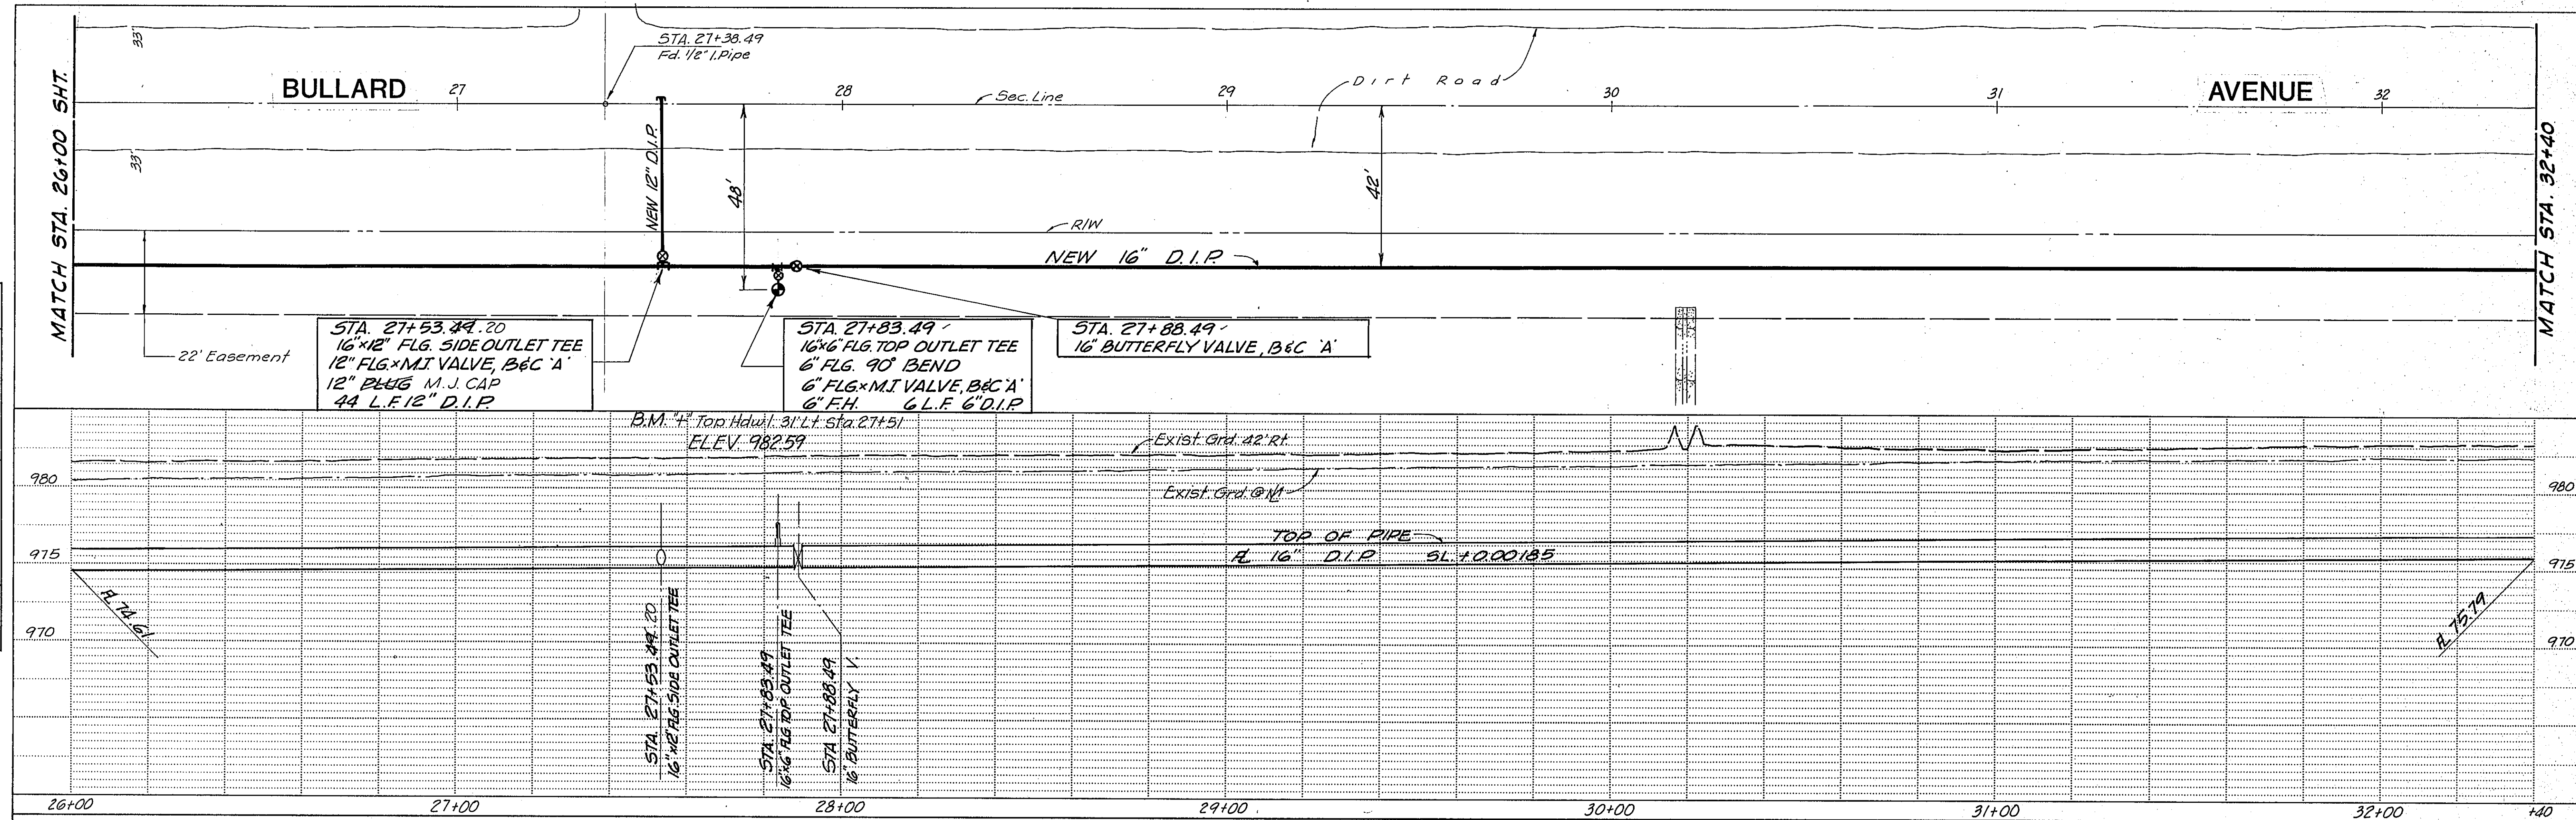

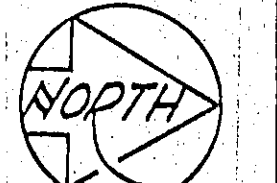



 SCALES:
 Horiz: 1"=20'
 Vert: 1"=5'

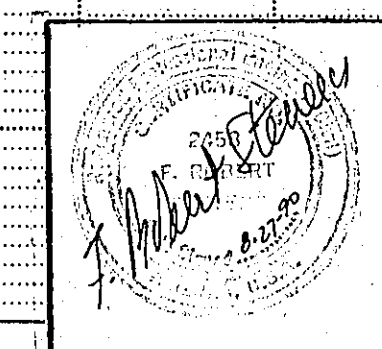


CITY OF GOODYEAR, ARIZONA
 BULLARD AVE. - VAN BUREN ST. WATERLINE
 STA. 26+00 TO STA. 38+60
 YOST AND GARDNER ENGINEERS
 2619 N. 3RD STREET - PHOENIX, ARIZ.
 Dr. J. E. B. Ck. GCB Date: 6/19/90 Job No. 6355 Sht. 5 / 10

DATE
BY
SURVEYED
PLANNING CHECKED
NOTED
RT. OF WAY CHECKED
PLAN
NOTE BOOK NO.

DATE
BY
SURVEYED
CHECKED
B.M. NOTED
STRUCTURE NOTATIONS CHKD
PROFILE
NOTE BOOK NO.

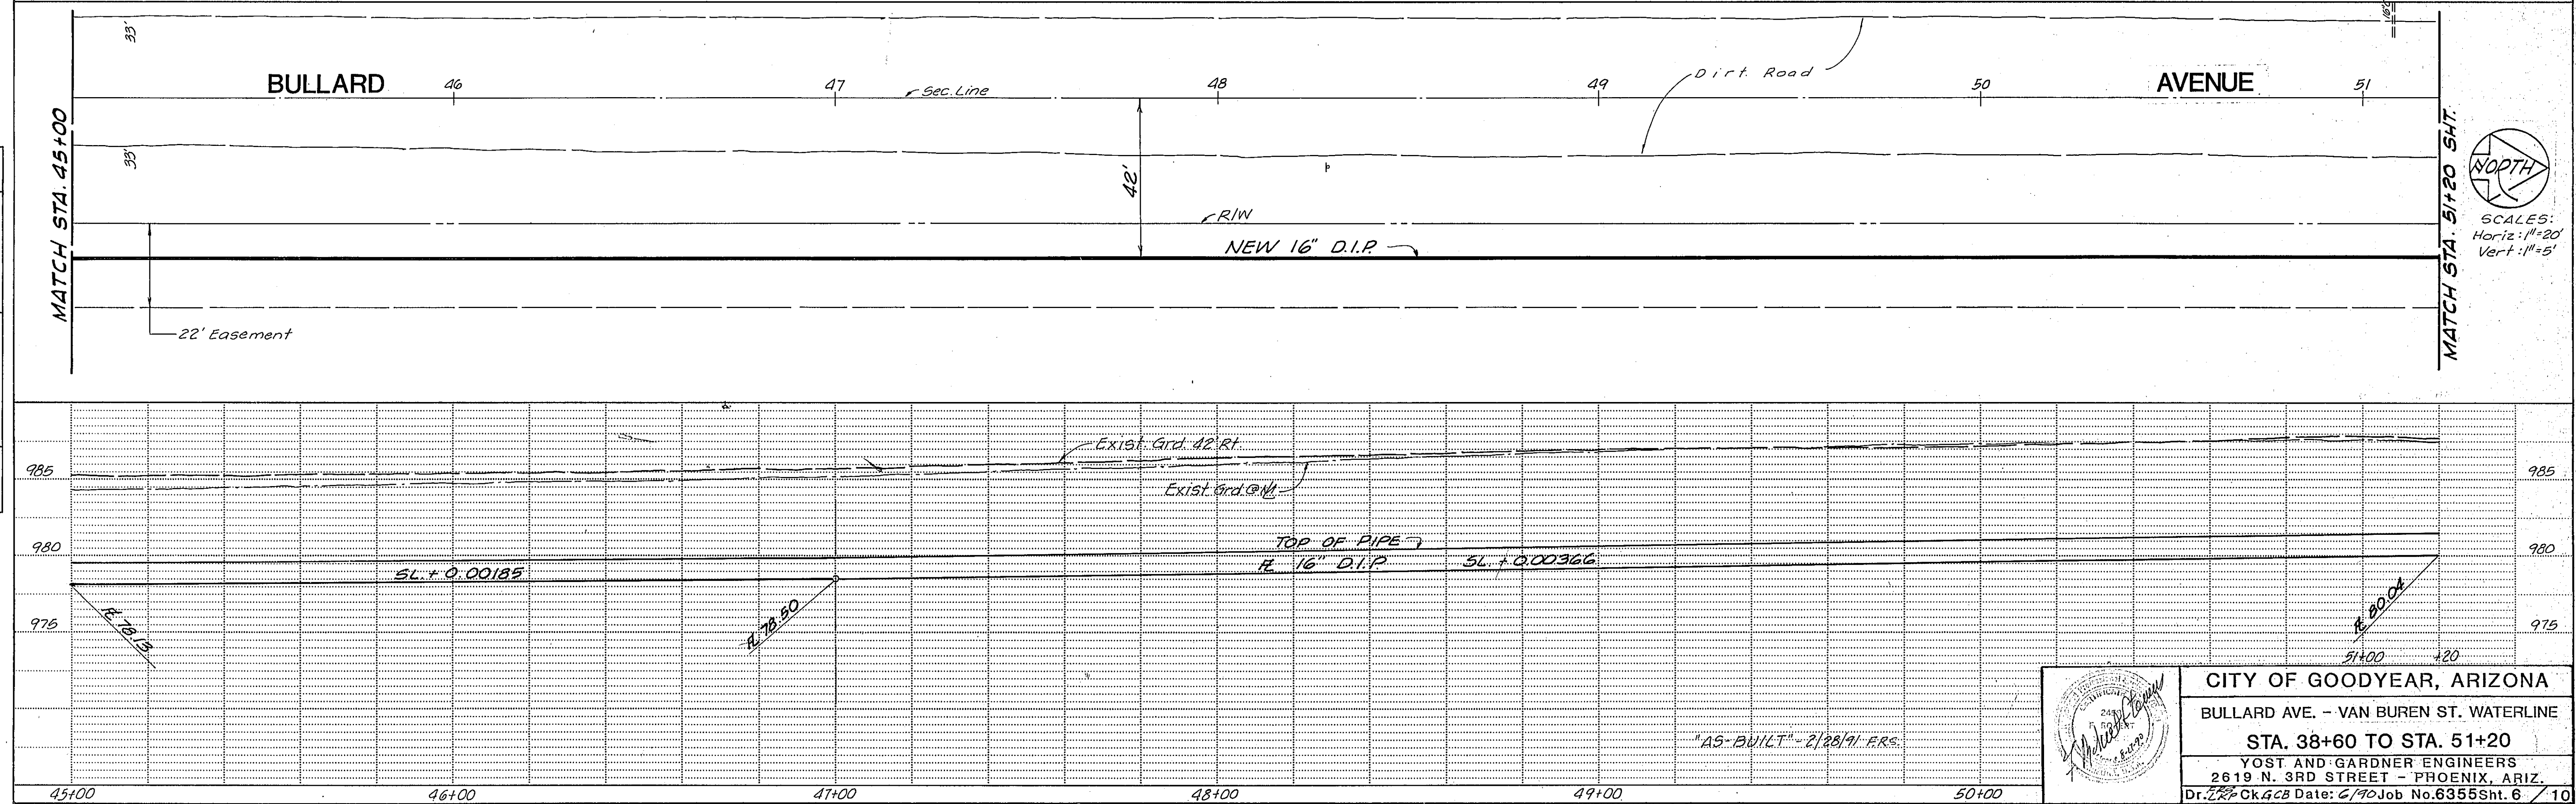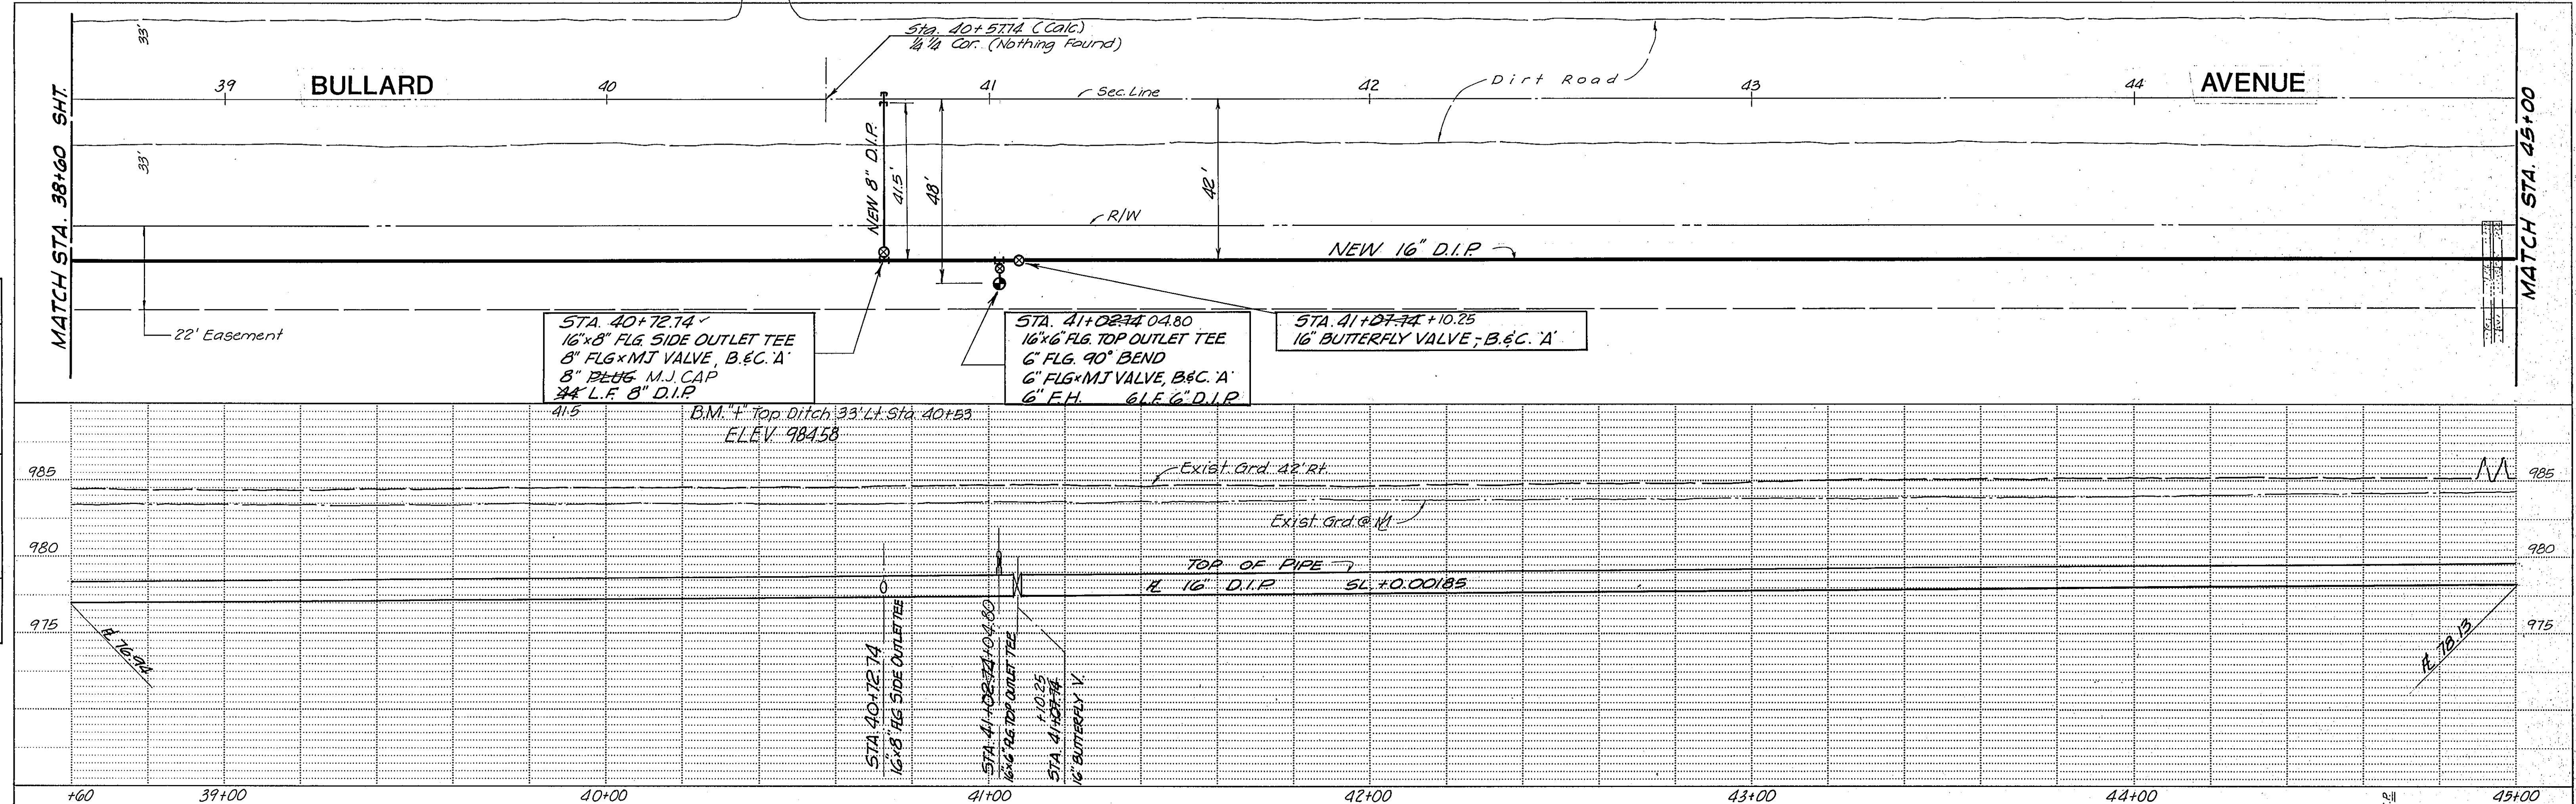






NORTH
SCALES:
Horiz: 1"=20'
Vert: 1"=5'

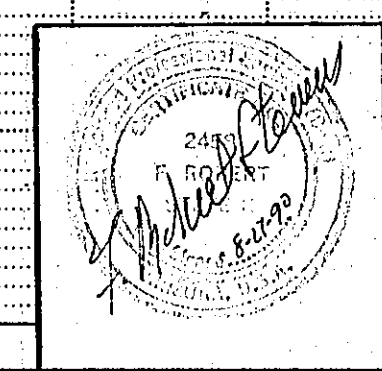

CITY OF GOODYEAR, ARIZONA
BULLARD AVE. - VAN BUREN ST. WATERLINE
STA. 38+60 TO STA. 51+20
YOST AND GARDNER ENGINEERS
2619 N. 3RD STREET - PHOENIX, ARIZ.
Dr. J. R. Ck. GCB Date: 6/90 Job No. 6355 Sht. 6 / 10

BY: _____ DATE: _____
 SURVEYED _____
 PLOTTED _____
 CHECKED _____
 NOTE BOOK NO. _____
 STRUCTURE NOTATIONS CHKD _____




BY: _____ DATE: _____
 SURVEYED _____
 PLOTTED _____
 CHECKED _____
 NOTE BOOK NO. _____
 STRUCTURE NOTATIONS CHKD _____

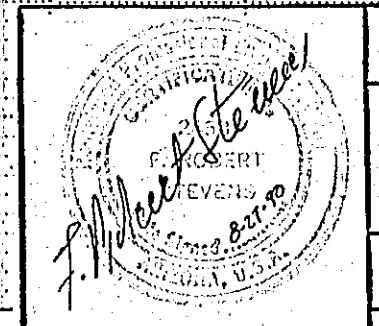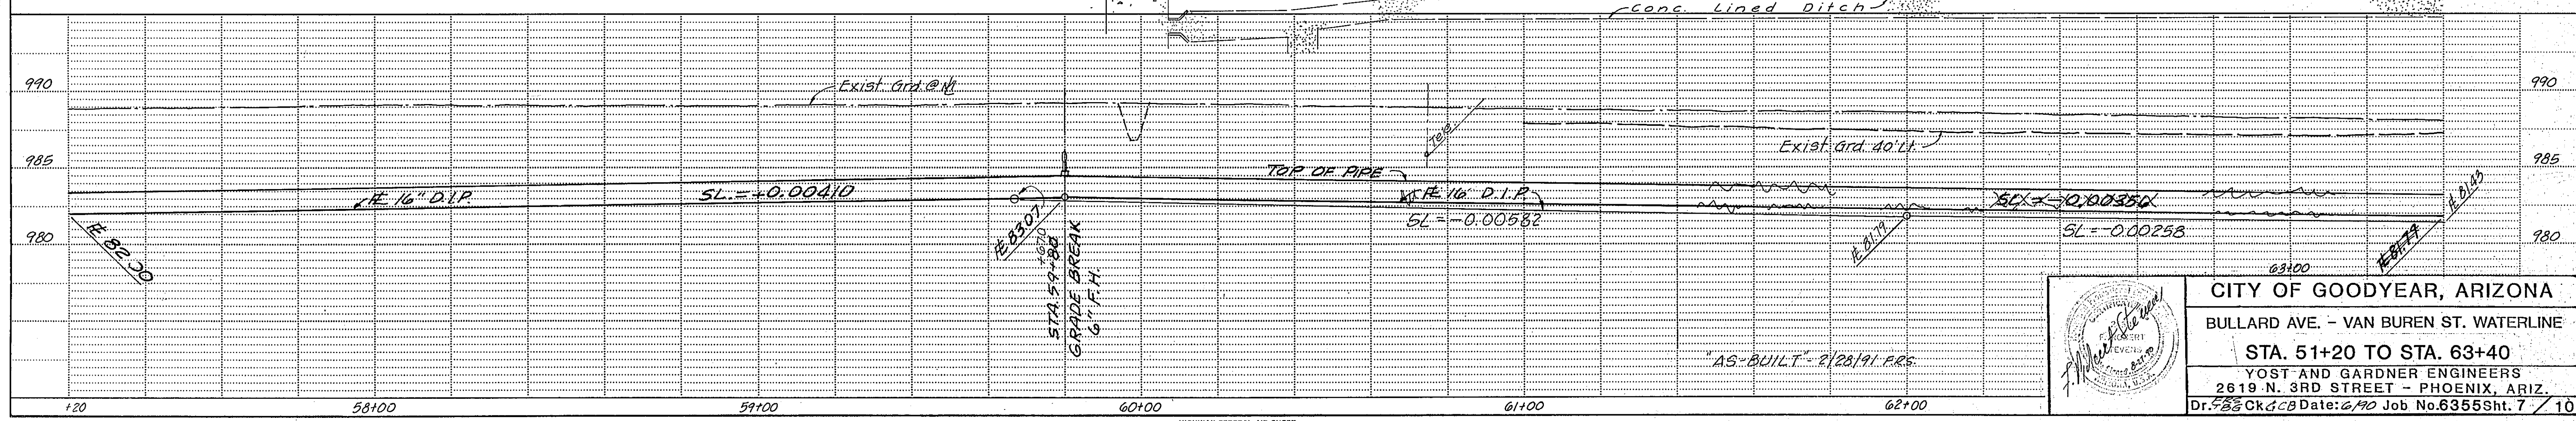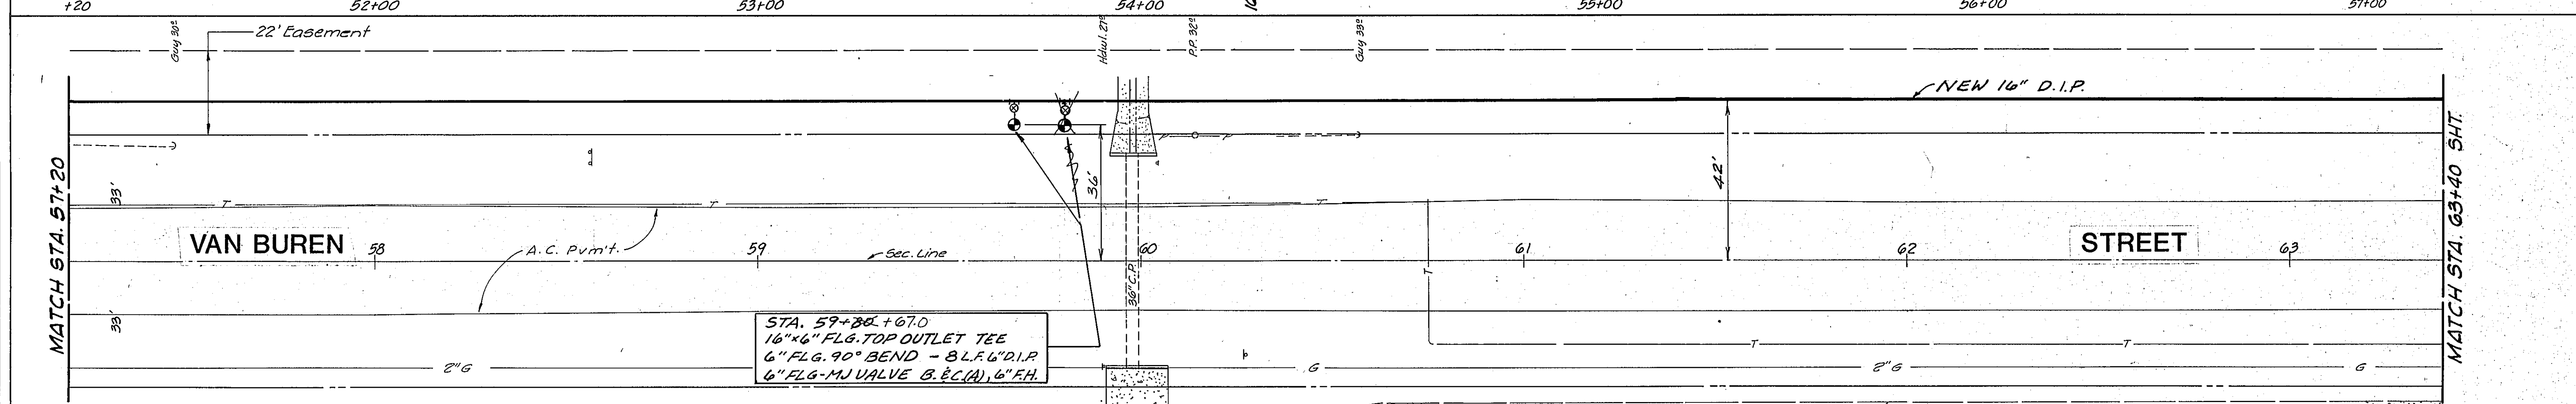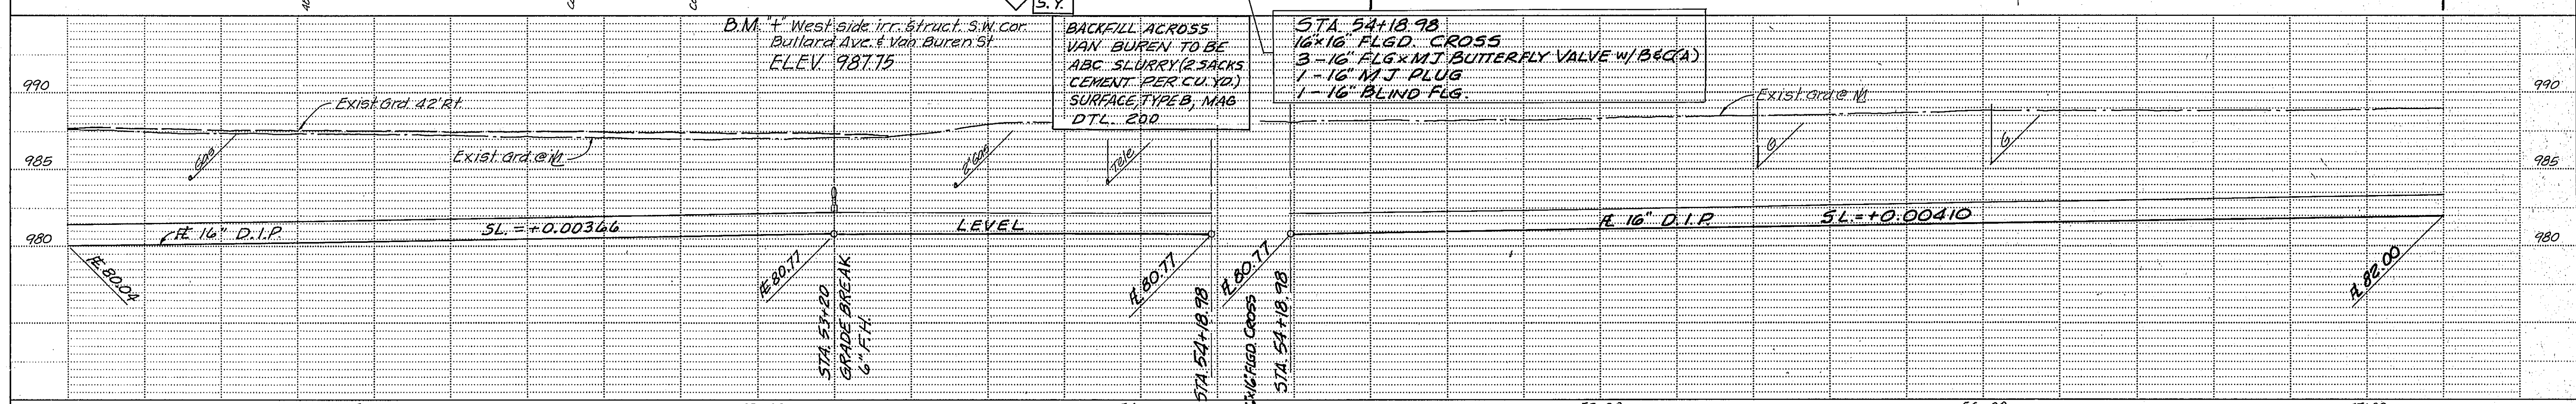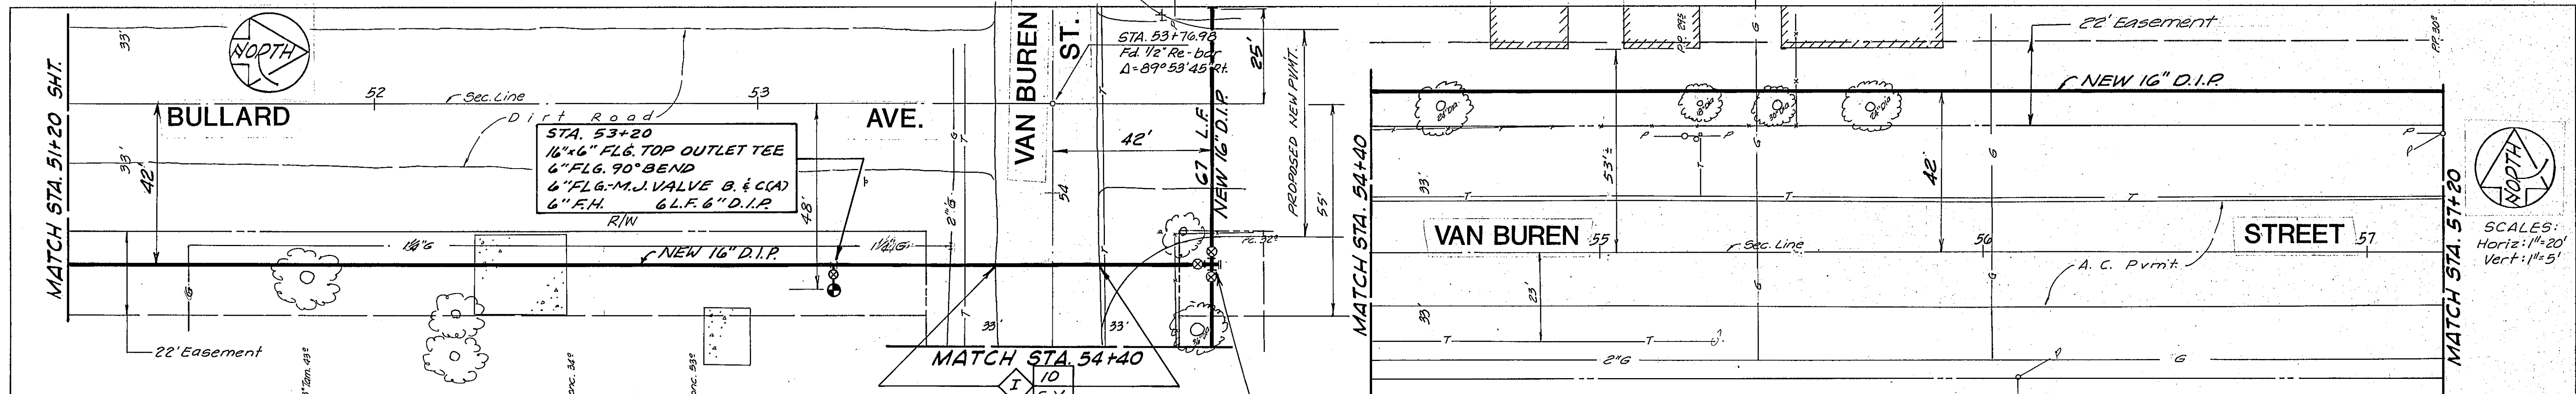

CITY OF GOODYEAR, ARIZONA
 BULLARD AVE. - VAN BUREN ST. WATERLINE
 STA. 51+20 TO STA. 63+40
 YOST AND GARDNER ENGINEERS
 2619 N. 3RD STREET - PHOENIX, ARIZ.
 Dr. 2819 Ck. 3 Date: 6/90 Job No. 6355 Sht. 7 / 10

DATE	
BY	
DESIGNED	
PLOTTED	
GRADES CHECKED	
ALIGNMENT CHECKED	
RT. OF WAY CHECKED	
PLAN NO.	
NOTE BOOK NO.	






DATE	
BY	
DESIGNED	
PLOTTED	
GRADES CHECKED	
ALIGNMENT CHECKED	
RT. OF WAY CHECKED	
PROFILE NO.	
NOTE BOOK NO.	
STATIONING NOTATIONS CHKD	

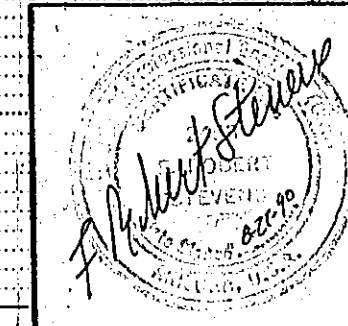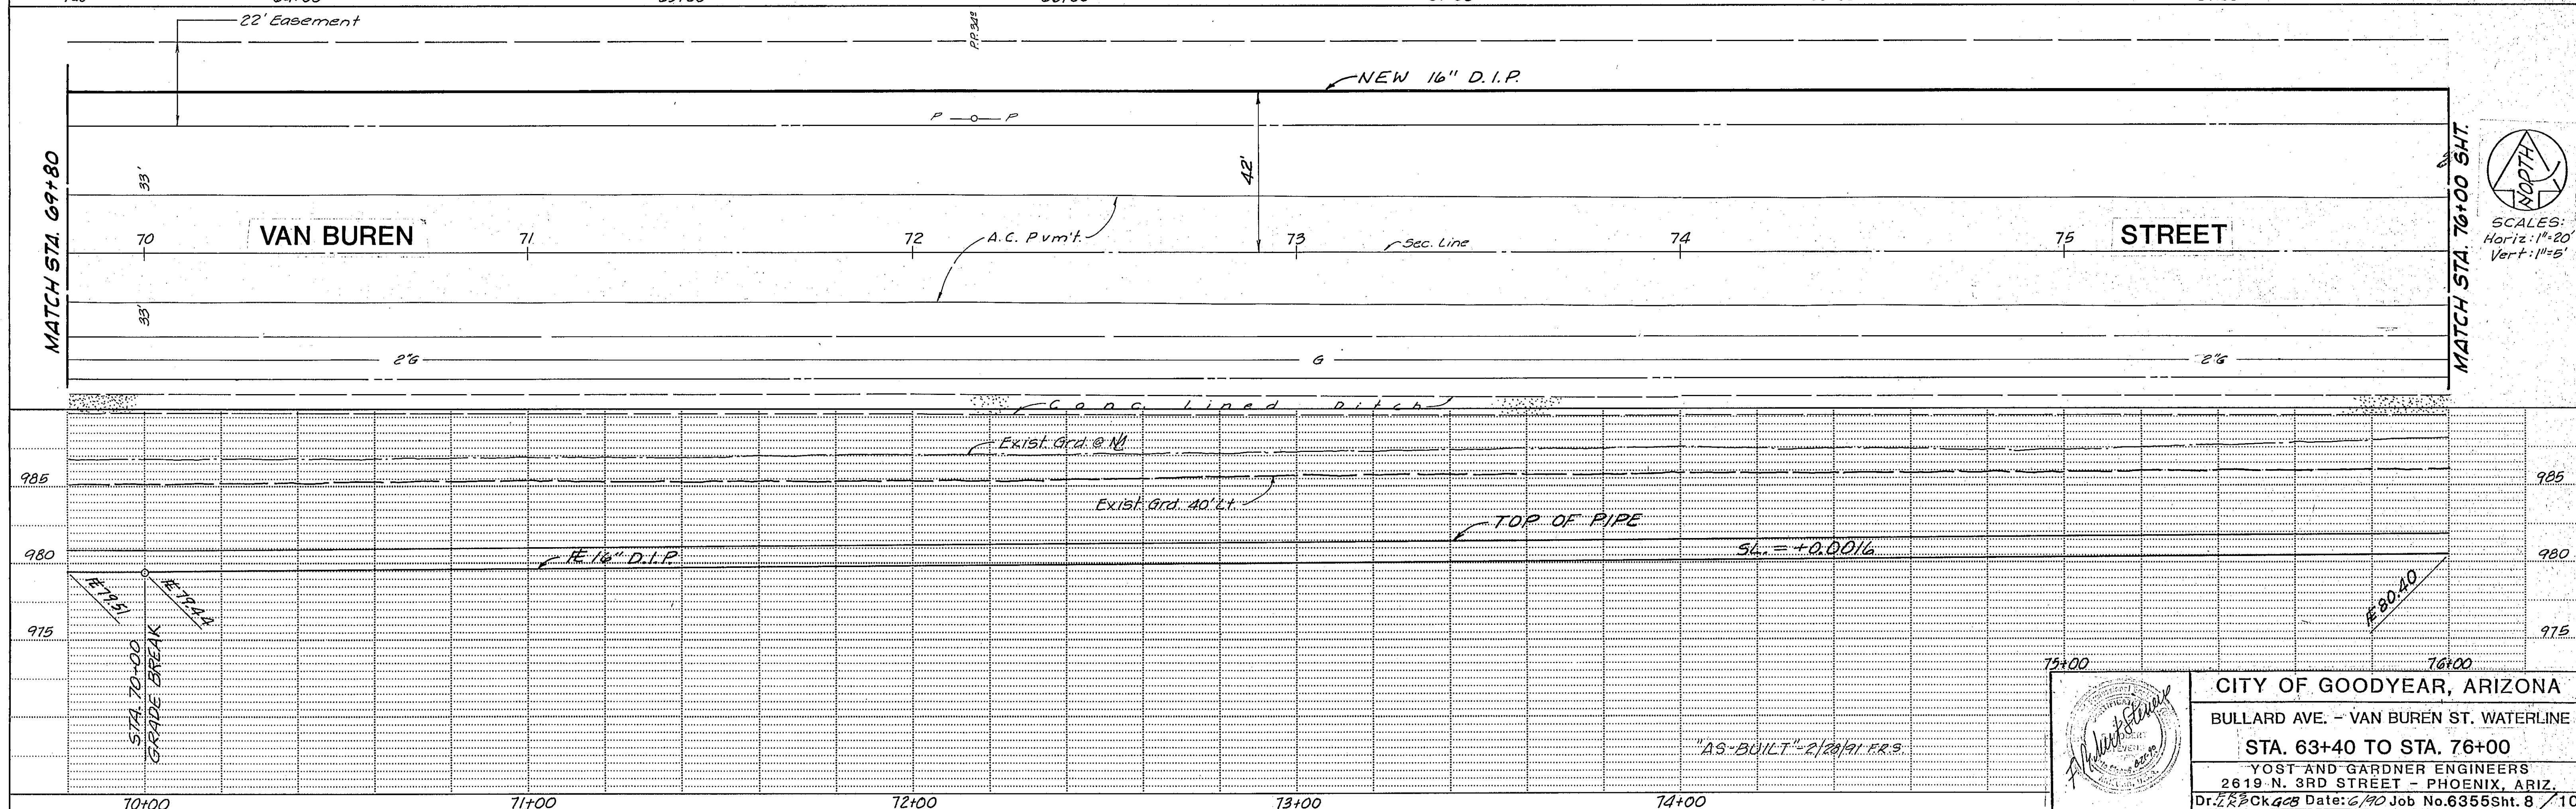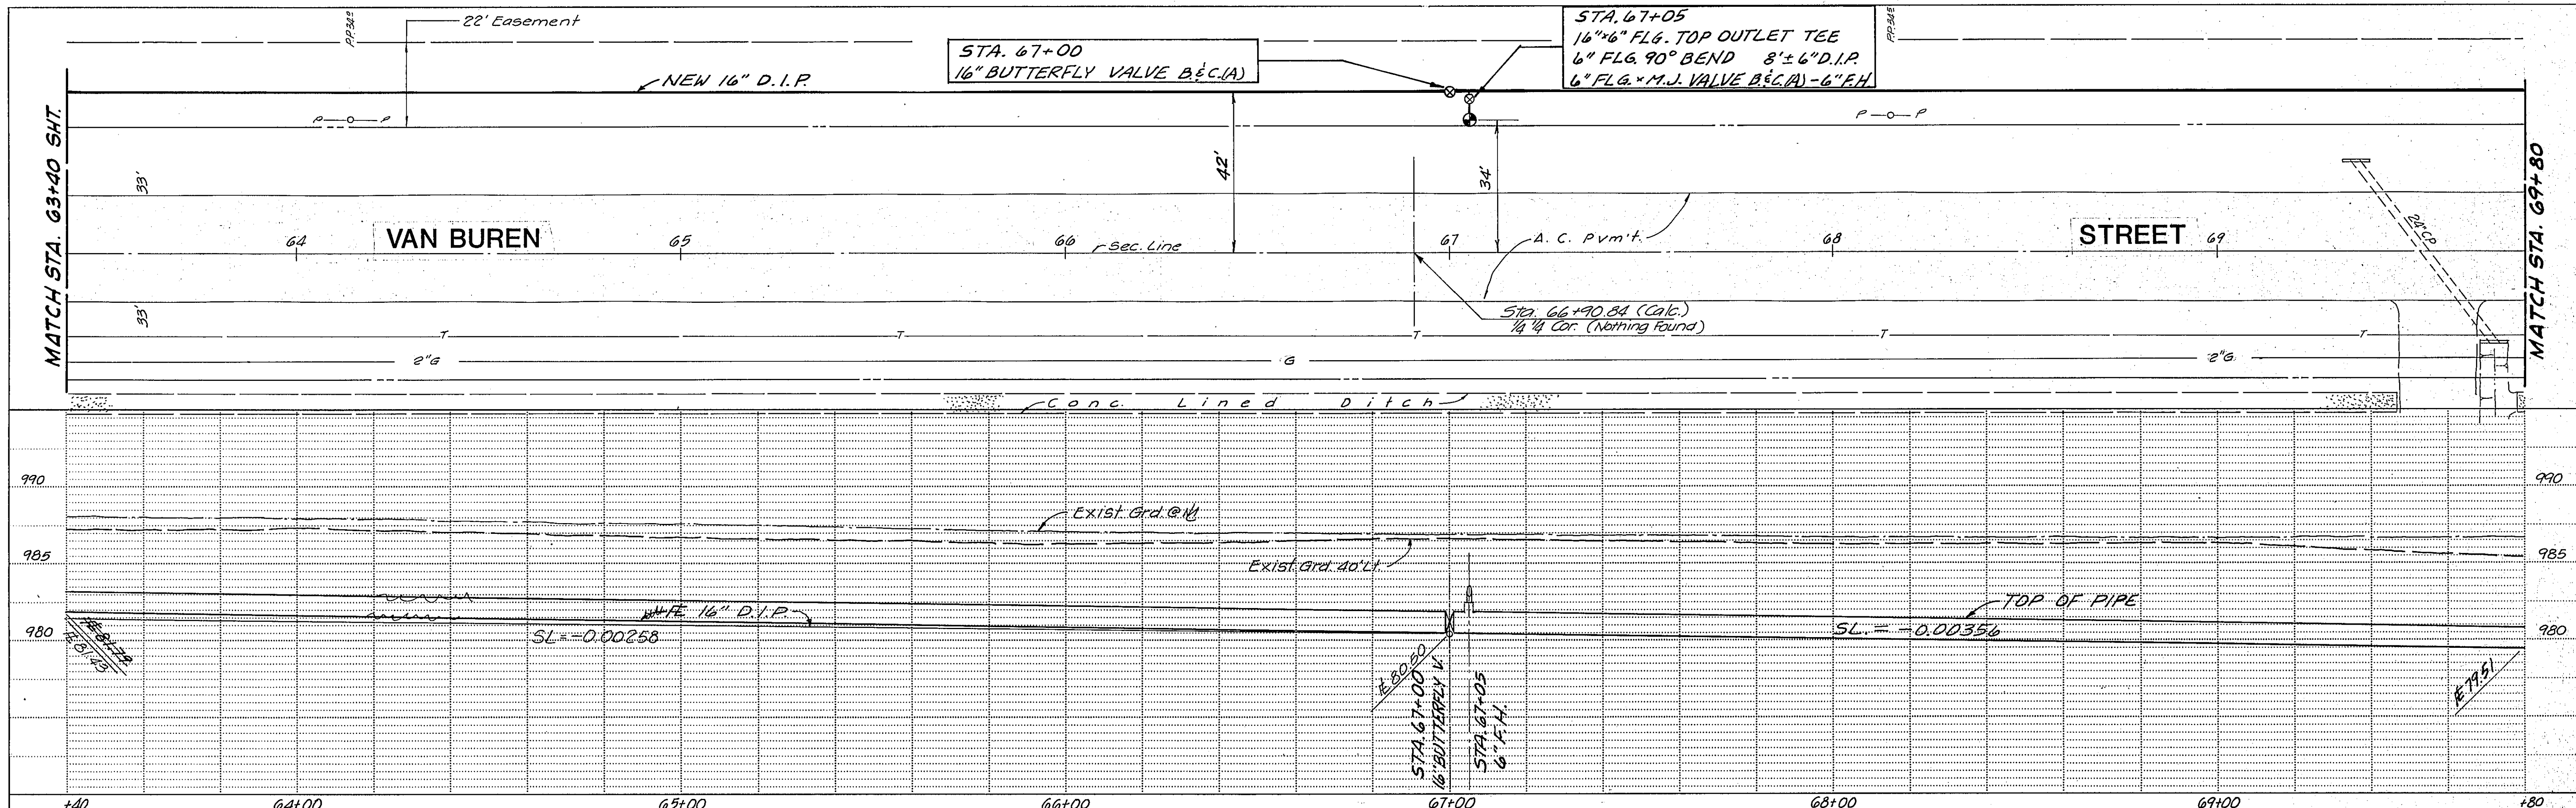

CITY OF GOODYEAR, ARIZONA
 BULLARD AVE. - VAN BUREN ST. WATERLINE
 STA. 63+40 TO STA. 76+00
 YOST AND GARDNER ENGINEERS
 2619 N. 3RD STREET - PHOENIX, ARIZ.
 Dr. J. K. Ck. g. 28 Date: 6/90 Job No. 6355 Sht. 8 / 10

PLAN	BY	DATE
SURVEYED		
ALIGNED		
CHECKED		
RT. OF WAY		
NO.		

PROFILE	BY	DATE
PLOTTED		
CHECKED		
NO.		
STRUCTURE		
NOTATIONS		
CHKD		

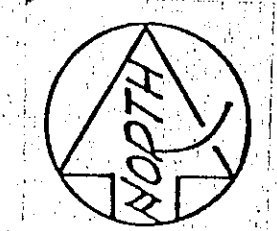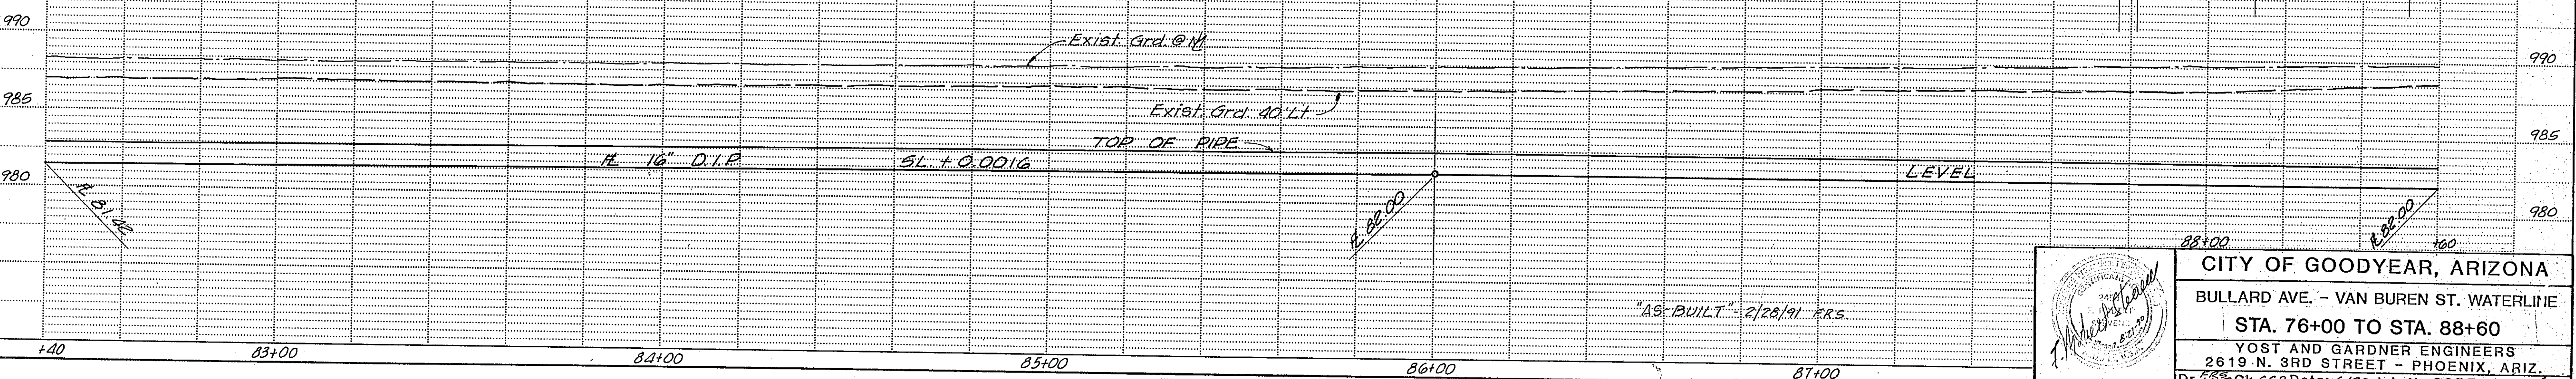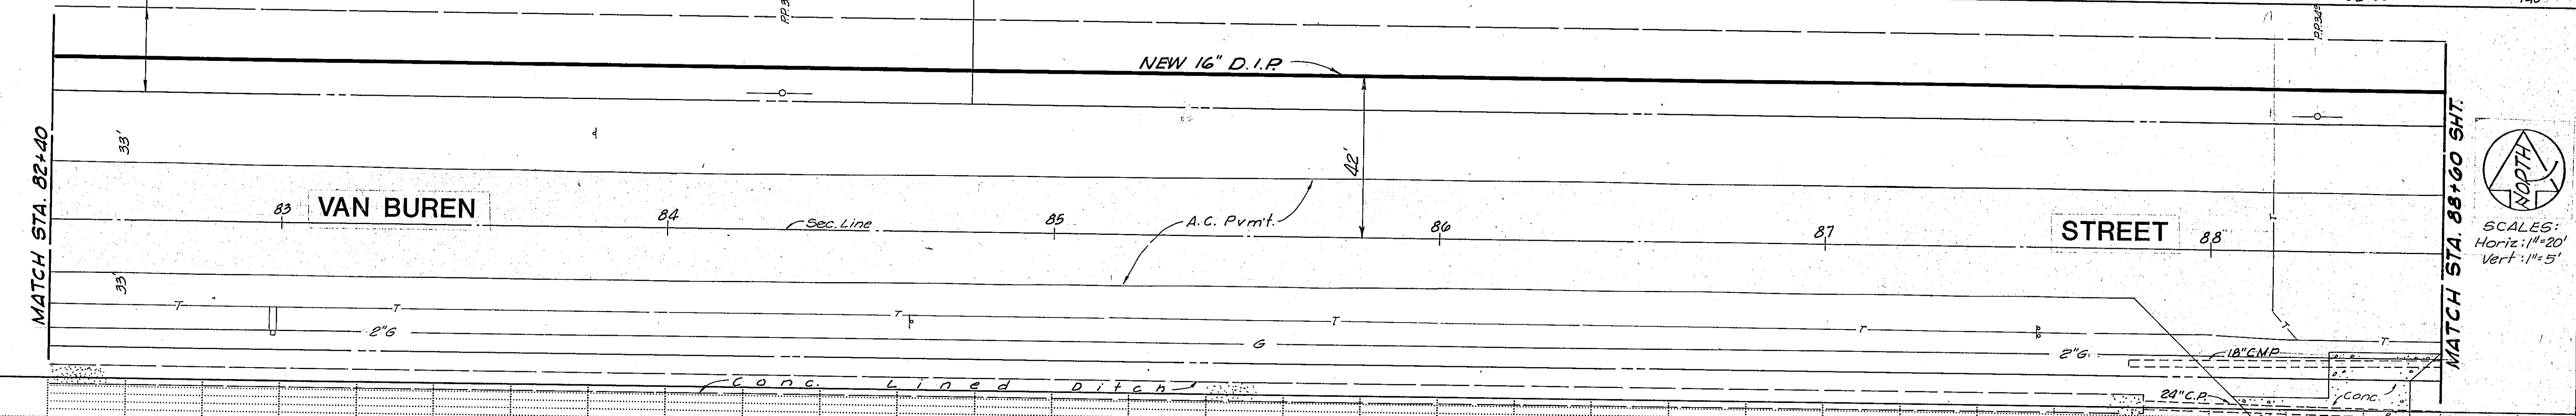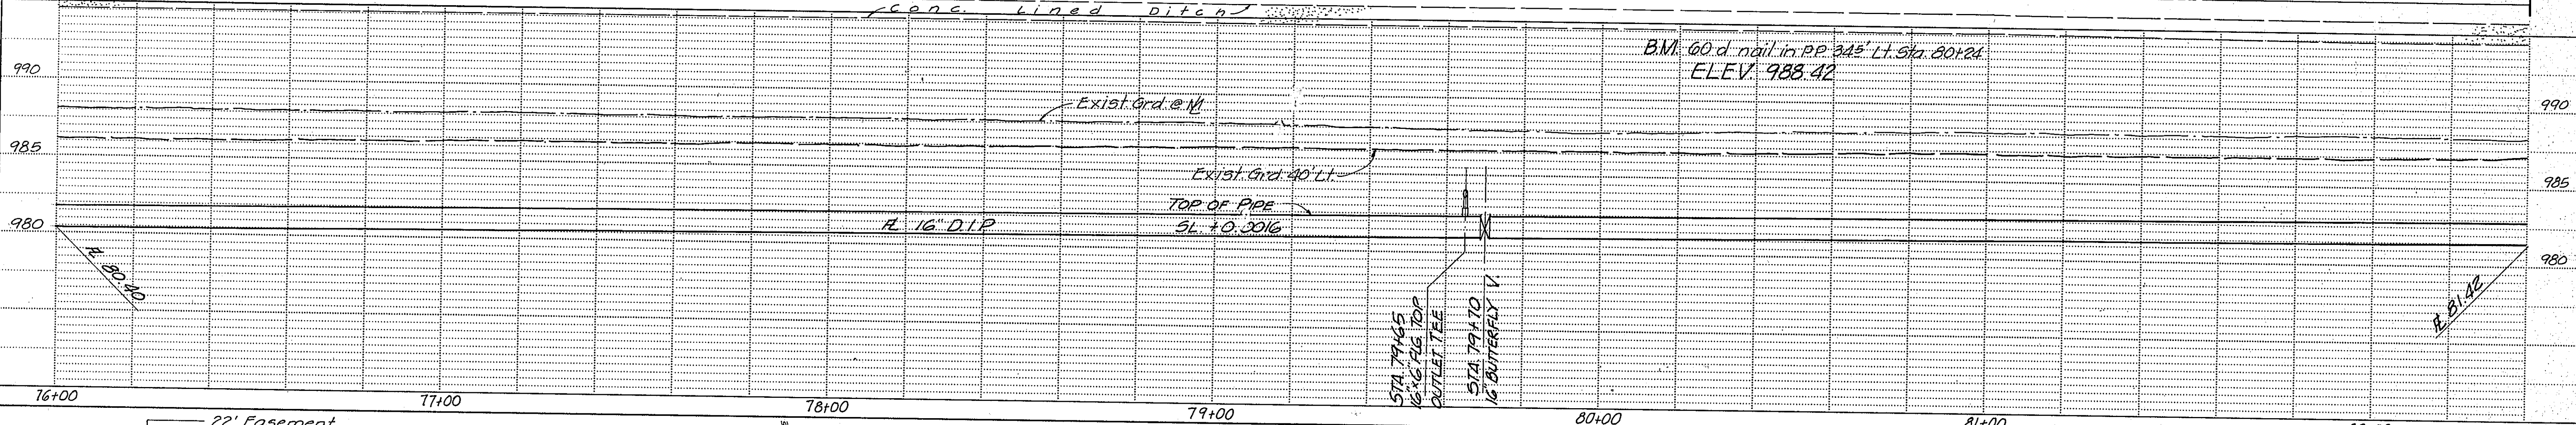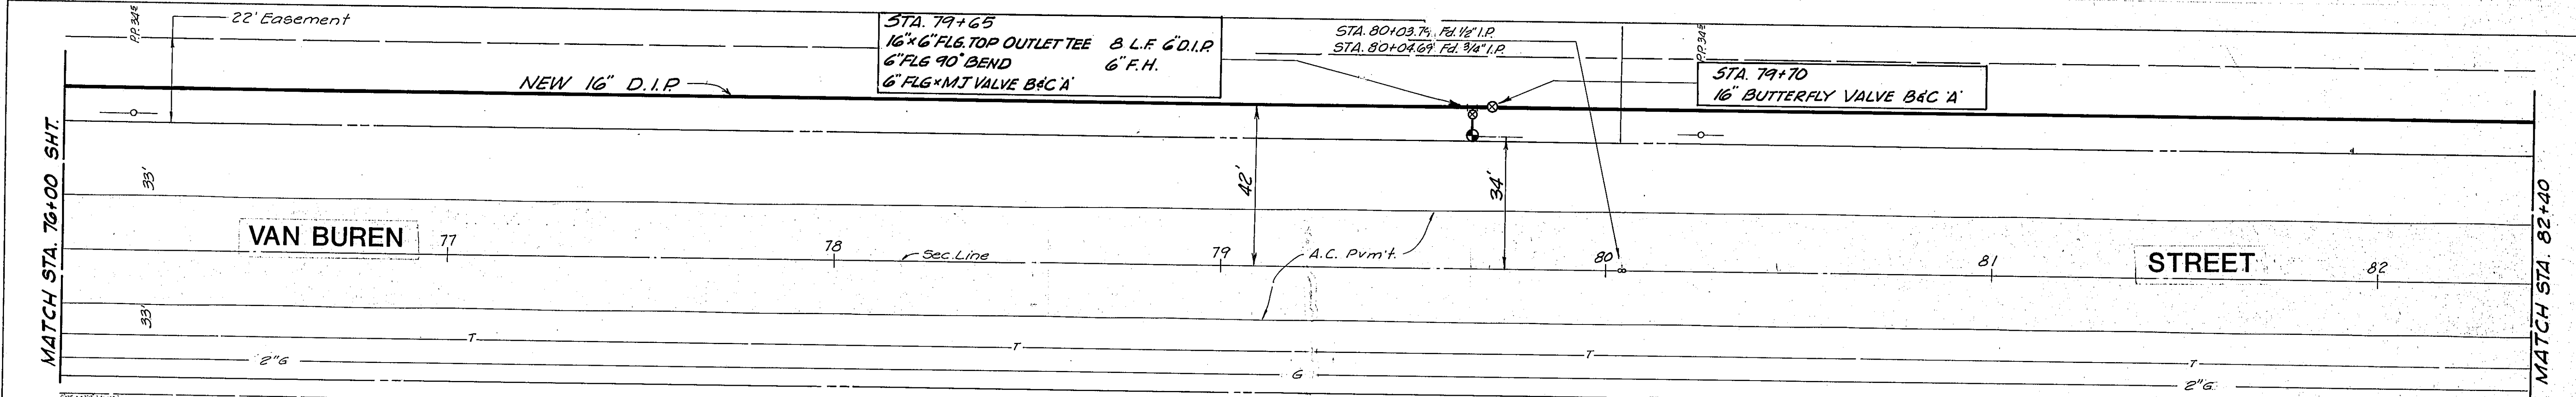



SCALES:
 Horiz: 1"=20'
 Vert: 1"=5'



CITY OF GOODYEAR, ARIZONA
 BULLARD AVE. - VAN BUREN ST. WATERLINE
 STA. 76+00 TO STA. 88+60
 YOST AND GARDNER ENGINEERS
 2619 N. 3RD STREET - PHOENIX, ARIZ.
 Dr. [Signature] Ck. GCB Date: 6/70 Job No. 6355 Sht. 9 / 10

DATE	
BY	
REVISIONS	
NO.	
DESCRIPTION	
DATE	
BY	
NO.	
DESCRIPTION	
DATE	
BY	
NO.	
DESCRIPTION	
DATE	
BY	
NO.	
DESCRIPTION	

DATE	
BY	
REVISIONS	
NO.	
DESCRIPTION	
DATE	
BY	
NO.	
DESCRIPTION	
DATE	
BY	
NO.	
DESCRIPTION	
DATE	
BY	
NO.	
DESCRIPTION	

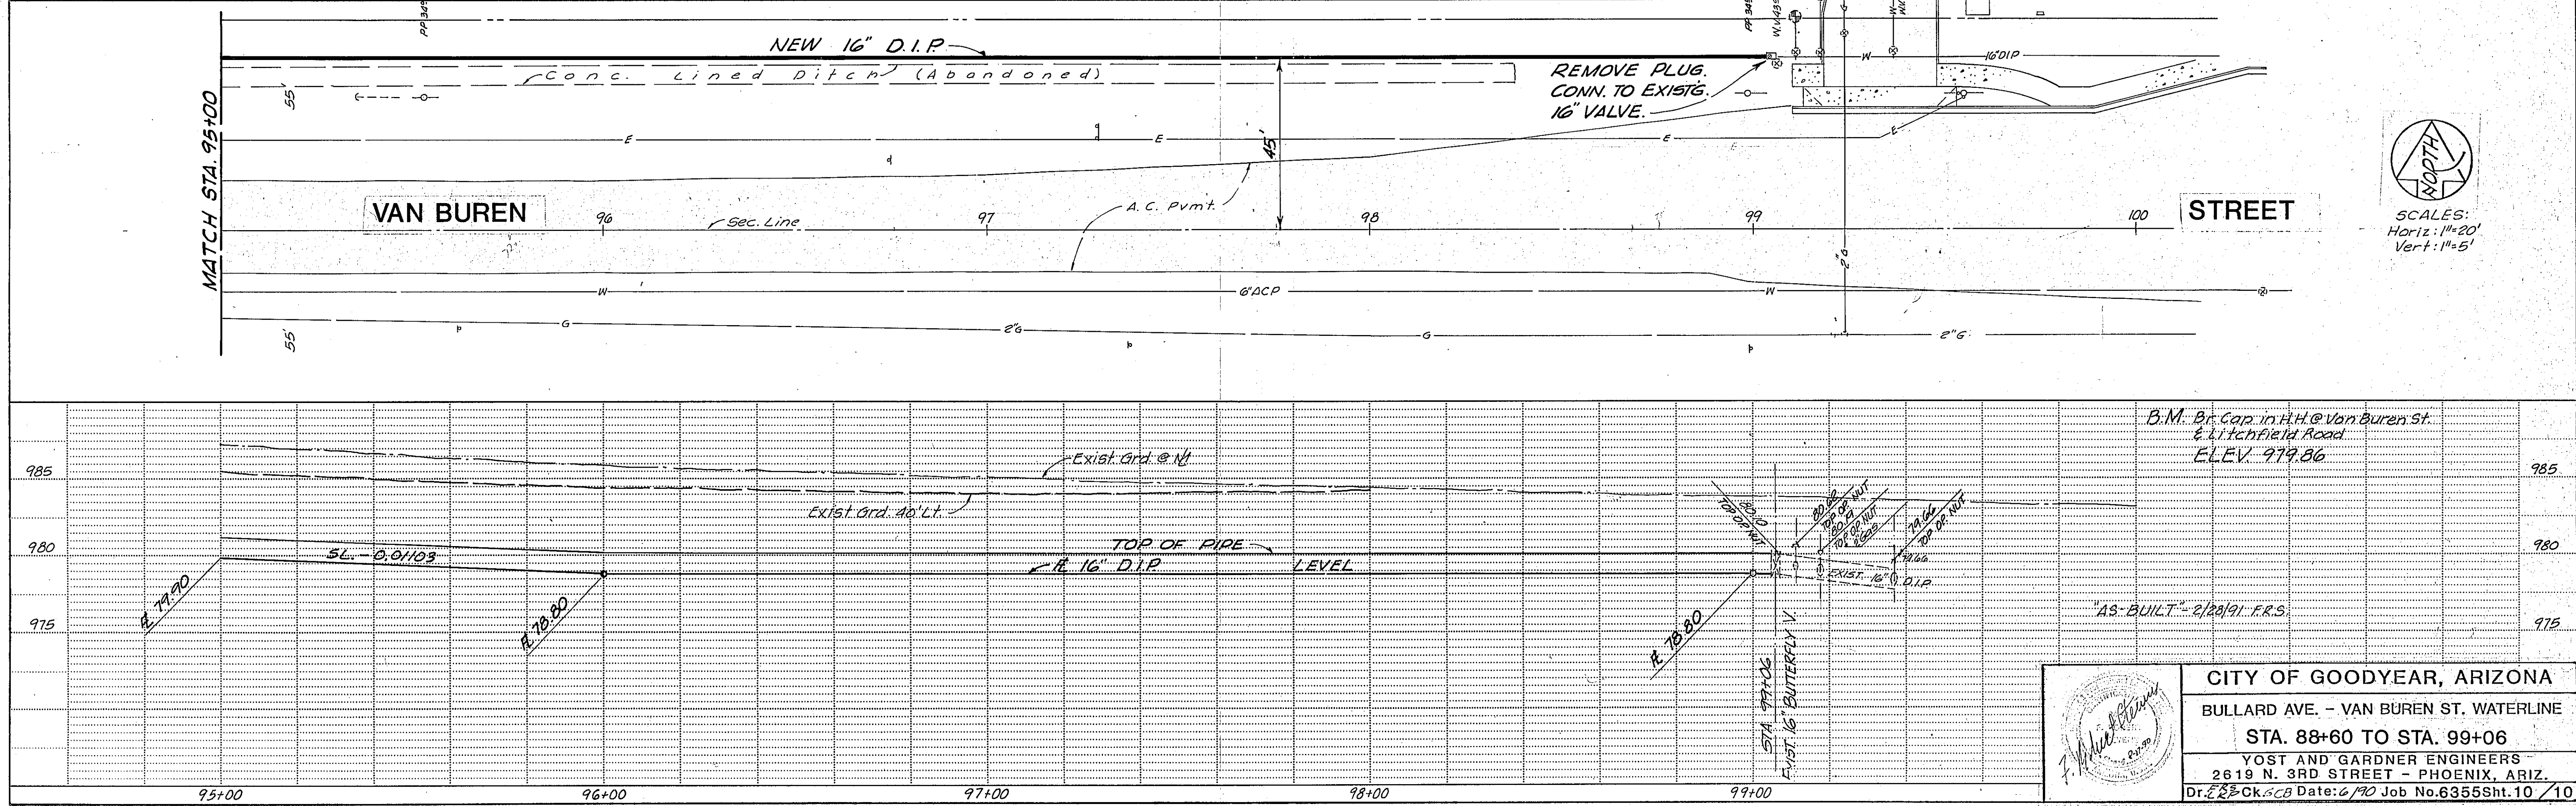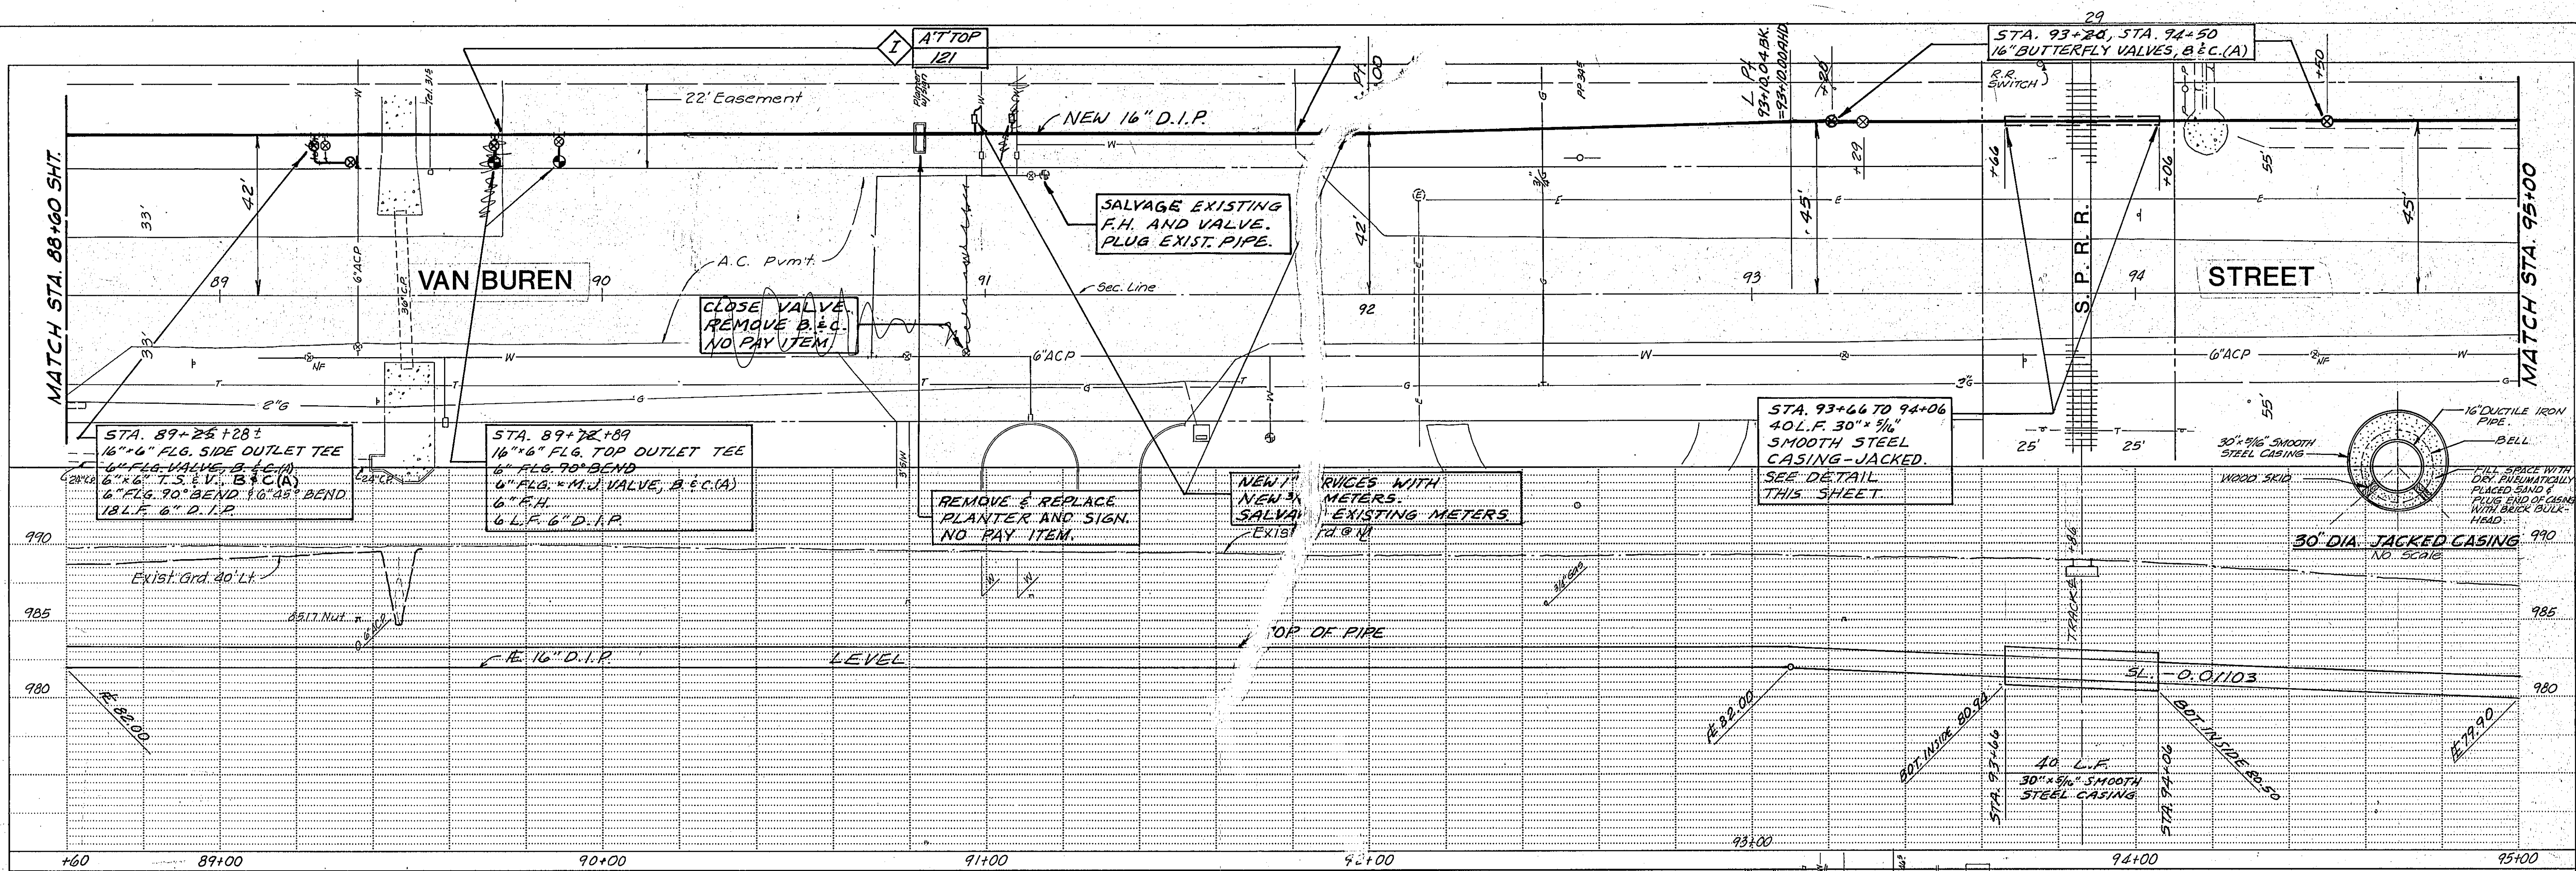

CITY OF GOODYEAR, ARIZONA
 BULLARD AVE. - VAN BUREN ST. WATERLINE
 STA. 88+60 TO STA. 99+06
 YOST AND GARDNER ENGINEERS
 2819 N. 3RD STREET - PHOENIX, ARIZ.
 Dr. [Signature] Date: 6/19/90 Job No. 6355Sht. 10 / 10